

KANSAS

Section 17 Township 14 Range 19

Well No. #1 Irvin

Company Derby Drlg.

NORTH

	0						

WEST

EAST

SOUTH

Sec. 17 Twp. 14 R. 19W

Well No. #1 Irvin Farm _____

Derby Drlg. Company _____

Rocket Drlg. Contractor _____

S. Irvin Pool


990 Ft. from N. Line

_____ Ft. from S. Line

_____ Ft. from E. Line

990 Ft. from W. Line

SE NW NW

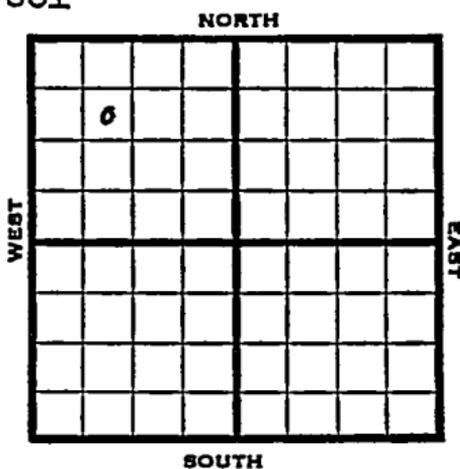

1953 Elev. 2197' REPORT

8/12 Spud 8-5-53
8" @ 191'
Anhy 1485'
Drlg 3332'

8/19 Spud 8-5-53 D & A TD 3844
8" @ 191 Anhy 1485 Heeb 3453
Lans 3498
DST 3694-3723 open 1 hr rec 70' O & GCM
160# Cong 3804
DST 3800-27 open 65 min rec 90' SOCM
820# Arb. 3832
DST 3798-3835 open 1 1/4 hr rec 60' SOCM
320#
DST 3835-44 open 1 1/2 hr rec 60' WCM
90' wtr. 1100#
TD 3844' D & A

ABANDONED

