
FORM 51 10M 8-47

KANSAS Ellis

Section 16 Township 14 Range ~~19W~~

Well No. #1 Kraus "B"

Company W. C. McBride

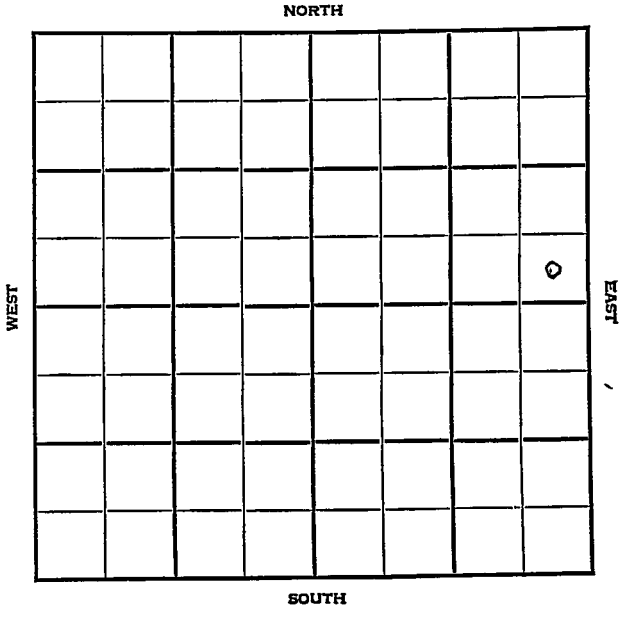

FORM 252-A
5M 4-48 PETROL

KANSAS Ellis

Sec. 16 Twp. 14 R. 19W

Well No. #1 Kraus "B" Farm

W. C. McBride Company

Wildcat


_____ Ft. from N. Line

330' Ft. from S. Line

330' Ft. from E. Line

_____ Ft. from W. Line

SE NE

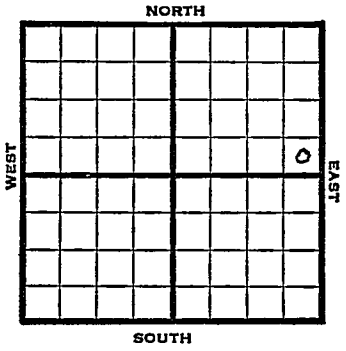

1948	Elev 2181' REPORT
5/26	Surface Hole
6/1	8" @ 214' Drlg. 1615'
6/9	Drlg 3766'
6/16	TD 3929' Lansing 3473' Cong, 3795' Arb. 3876' Aband.

ABANDONED

Form 26—200 Bks.—1-48—Palace

Wildcat

Kansas

Map No. _____ Sec. 16 Twp. 14 R. 19W


Well No. 1 Kraus "B"

W. C. McBride Company

FIRST REPORT Contractor

SE NE

SECTION PLAT

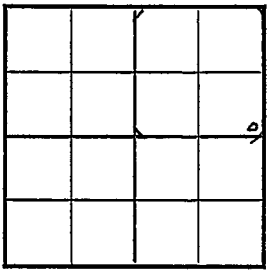

_____ Ft. from N. Line

330 Ft. from S. Line

330 Ft. from E. Line

_____ Ft. from W. Line

Ellis County

Location _____

Rig up _____

Drilling and Remarks:

surface hole

RECORD

Cased _____ in., _____ ft.

Sand _____

Gas _____

Oil _____

Total Depth _____

PRODUCTION

1st 24 hrs. Nat. _____

1st 24 hrs. after shot _____

Gas _____ Cu. Ft.

Dry Hole _____

Abandoned _____

Date

MAY 26 1948 19____ S. J. LEWIS Scout

Form 26—200 Bks.—1-48—Palace

Wildcat

Kansas

Map No. 70 Sec. 16 Twp. 14 R. 19W

Well No. 1 Kraus "B"


W. C. McBride Company

ABANDONED Contractor

SE NE

F.1287

SECTION PLAT

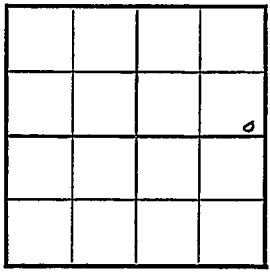

____ Ft. from N. Line

330 Ft. from S. Line

330 Ft. from E. Line

____ Ft. from W. Line

Ellis County

Location

Rig up

Drilling and Remarks:

Lime 3473

Conq 3795

RTD 3876

RECORD

Cased ____ in., ____ ft.

Sand

Gas

Oil

Total Depth 3928

PRODUCTION

1st 24 hrs. Nat.

1st 24 hrs. after shot

Gas ____ Cu. Ft.

Dry Hole

Abandoned

Date

JUN 16 1948 19____ S. J. LEWIS Scout