


Section 17 Township 34 Range 3E

Well No. #³1 Warren

Company Prairie Oil Gas

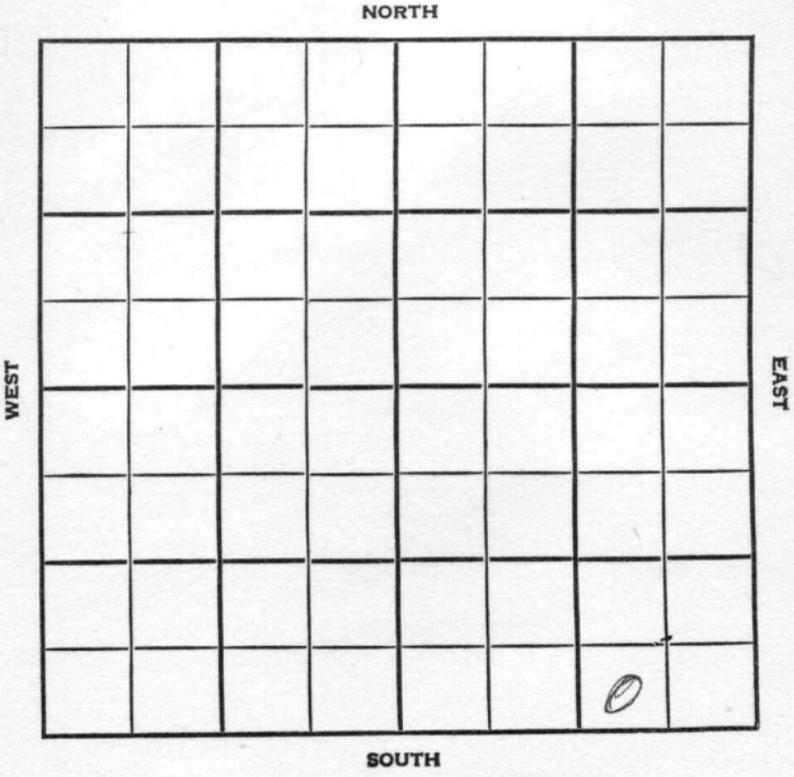

County Cowley Elev. 1143
 Sec. 17 Twp. 34 Rge. 3E
 Company Prairie Oil Gas
 Farm Name Warren No. 4

TOPS	DEPTH	LOG	DATUM	Loc. in Sec.
Anh.				SW SE SE
Tp.				
H.				
Tr.				
Dg.				
B.L.				
L.				Geol.
K.C.				Contr.
B.K.C.				
Ce.				
C.				
M.				Pool
M.				Baird
K.				
Mz.				
Mo.				
V.				
S.				
S.				
A.				
R.				
Pc.				
G.				
T.D.				

FIRST REPORT
 NOV 14 1956

Date Comm. spd. 11-10-56
8" @ 130 w/120, Drlg. 530

NOV 5 0 1956

R.G.

Handwritten signature/initials

Co.

Lse.

No.

Sec.

T.

R.

