
Cowley KANSAS

SECTION 18 TOWNSHIP 34 RANGE 3 E

WELL NO. # 1 ~~Hanson~~ Wright

COMPANY L. C. Smitherman

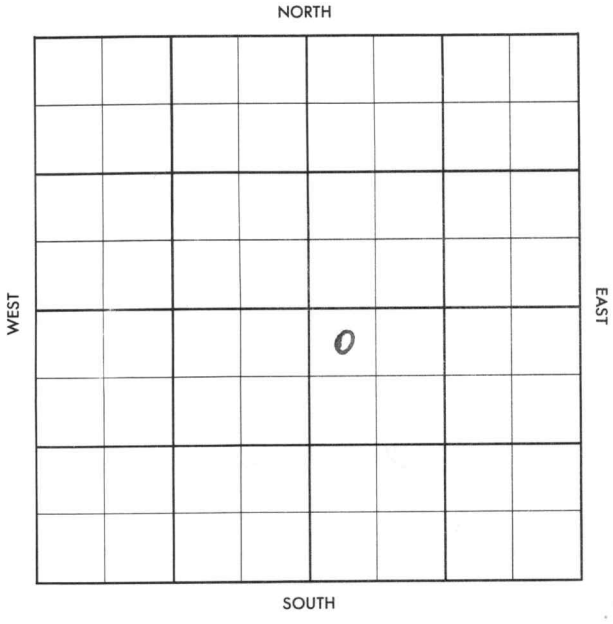

FORM 504-3 SUNRAY

Cowley KANSAS

SEC.	TWP.	R.
18	34	3E

WELL NO.

#1 ~~Hanson~~ Wright FARM

COMPANY

L.C. Smitherman

CONTRACTOR

Rauckman


_____ Ft. from N. Line

_____ Ft. from S. Line

_____ Ft. from E. Line

_____ Ft. from W. Line

XX ~~NW NW SE~~
SW SW NE

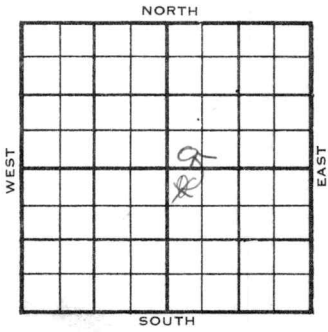

1956	ELEVATION 1117' REPORT
4-18	Surface Set
5-23	Comm. 4-20-56 8 5/8" @ 98 SD @ 3200 5½" @ 3378 w/75 CO 40/3350-60 Flw 1 1/3 boph, no/wtr. Frac, Flw 160 bopd, no wtr. Flw 25 bopd, no/wtr. Complete Bartl. 3345' TD 3378'

COMPLETED

DX-78

FORM 513 SUNRAY

County Cowley Elev.

Sec. 18 Twp. 34 Rge. 3E

Company L. C. Smitherman

Farm Name Hanson No. 1

TOPS	DEPTH	LOG	DATUM
Anh.			
Tp.			
H.			
Tr.			
Dg.			
B.L.			
L.			
K.C.			
B.K.C.			
Ce.			
C.			
M.			
M.			
K.			
Mz.			
Mo.			
V.			
S.			
S.			
A			
R.			
P€.			
G.			
T.D.			

Loc. in Sec. NW NW SE

Geol.

Contr.

Pool Rauckman



Date Comm.

surface set

Co. Lse. No. Sec. T. R.

CORRECTION

FORM 513 SUNRAY

County Cowley Elev. ~~1119~~ 1117 Co.

Sec. 18 Twp. 34 Rge. 3E

Company L. C. Smitherman

Farm Name ~~Wright~~ Wright No. 1


TOPS	DEPTH	LOG	DATUM
Anh.			
T.P.			
H. Bartl	3345		
Tr.			
Dg.			
B.L.			
L.			
K.C.			
B.K.C.			
Ce.			
C.			
M.			
M.			
K.			
Mz.			
Mo.			
V.			
S.			
S.			
A			
R.			
P€.			
G.			
T.D.	3378		

Loc. in Sec. ~~NW NE~~ SW SW NE

Geol.

Contr. Lse.

Pool Rauckman

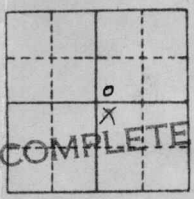

No.

Date Comm. MAY 23 1956 Sec.

surface set ~~APR 25 '56~~ 4-20-56 8 5/8

98 @ 1600 MAY 2 '56 S.D @ 3200 T.

MAY 9 '56 5½ @ 3378/75 MAY 15 '56 MICT

MAY 23 '56 CO 40/3350-60 Flw 1½

Bopb no/w Frac Flw 160 Bopd

no wtr. Flw 25 Bopd no/wtr R.

complete.