

KANSAS

FORM 51 5M 10-41 PETROL


Ellis

Section 17 Township 14 Range 19-W

Well No. #1 Kraus

Company Pryor & Lockhart

Wildcat

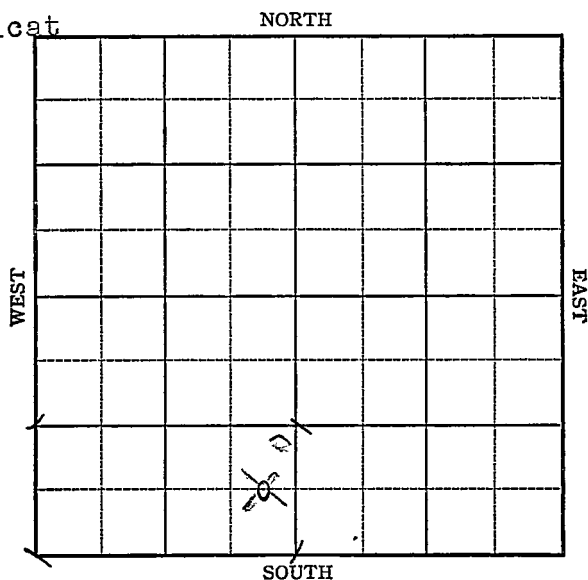

Sec. 17 Twp. 14 R. 19-WWell No. #1 Kraus FarmPryor & Lockhart Company

(Wildcat)

Ft. from N. Line

990~~660~~


Ft. from S. Line

330

Ft. from E. Line

Ft. from W. Line

Elev. 2179

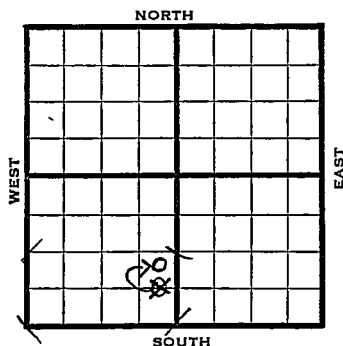

1942

REPORT

8/12

Location

8/19

"

8/27

"

9/2

Rotary

9/9

10" @ 97' Drlg 2350'

9/16

Topeka 3325 Drlg 3340

9/23

Lans. 3498'

SSO 3518-20

3566-67, 3671-75

BK 3756

Cong. sd 3798'

T. D. 3805 S.D.

5" 3798' RUST

9/30

TD 3805' filled 1000' oil 12 hrs
SD orders.

10/7

" "

10/14

" "

10/21

" " " " " " "

10/28

3805 filled 1000' oil 12 hrs SD orders

11/7

pump temp BP 49 oil

11/11

" " " "

11/18

" " " "

11/24

" " " "

OVER

KANSAS

Map No. 70 Sec. 17 Twp. 14 R. 19WWell No. 1 Kraus

Pryor & Lockhart


Company

FIRST REPORT

Contractor

C E L S E S W

SECTION PLAT

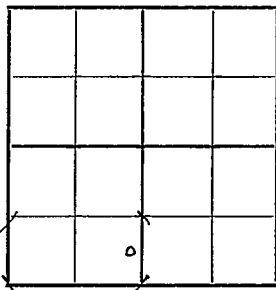

_____ Ft. from N. Line

660

_____ Ft. from S. Line

330

_____ Ft. from E. Line

_____ Ft. from W. Line

WILDCAT

Location X

Rig up _____

Drilling and Remarks:

RECORD

Cased _____ in., _____ ft.

Sand _____

Gas _____

Oil _____

Total Depth _____

PRODUCTION

1st 24 hrs. Nat. _____

1st 24 hrs. after shot _____

Gas _____ Cu. Ft.

Dry Hole _____

Abandoned _____

Date

AUG 12 1942

19

S. J. LEWIS

Scout

Ellis

KANSAS

Map No. 70 Sec. 17 Twp. 14 R. 19WWell No. 1 KrausPryor & Lockhart

Company

COMPLETED

Contractor

NE SE SW

SECTION PLAT

Ft. from N. Line

990 Ft. from S. Line330 Ft. from E. Line

Ft. from W. Line

WILDCAT

Location

Rig up

Drilling and Remarks:

*Core 3798**5-103798**Pump 49 P.X.**33 3/4 ft.*

RECORD

Cased _____ in., _____ ft.

Sand _____

Gas _____

Oil _____

Total Depth 3743

PRODUCTION

1st 24 hrs. Nat. _____

1st 24 hrs. after shot _____

Gas _____ Cu. Ft.

Dry Hole _____

Abandoned _____

Date

JAN 20 1943 19

S. I. LEWIS Scout

Ellis

Map No. 20 Sec. 17 Twp. 14 R. 19WWell No. 1 KrausPryor & Lockhart

Company

CORRECTION

Contractor

NE SE SW

 Ft. from N. Line990 Ft. from S. Line330 Ft. from E. Line Ft. from W. Line

SECTION PLAT

	o		

WILDCAT

Location Rig up

Drilling and Remarks:

Reported

C EL SE SW

RECORD

Cased in., ft.Sand Gas Oil Total Depth

PRODUCTION

1st 24 hrs. Nat. 1st 24 hrs. after shot Gas Cu. Ft.Dry Hole Abandoned

Date

SEP 2 1942 19S. J. LEWIS Scout

1942
 12/2 Pump Temp Pot 49 oil
 12/8 " "
 12/16 " "
 12/22 " "
 12/29 " "
 1943
 1/6 " "
 1/13 SD for pipe line.
 1/20 Cong. 3/98
 5" Casing set 3798
 Pump 49Pot.
 33.3 Gravity.
 TD 3803'

COMPLETED

COMPLETED