


Section 1 Township 28 Range 7E

Well No. #1 Lucas

Company Orval Parker

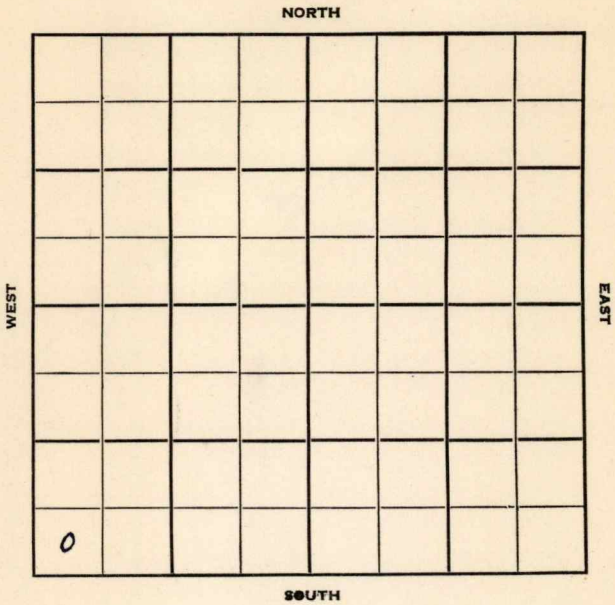

Butler

KANSAS

Sec. 1 Twp. 28 R. 7 E

Well No. # 1 Lucas Farm

Orval Parker Company

H & M Drlg. Contractor


\_\_\_\_\_ Ft. from N. Line

330 Ft. from S. Line

\_\_\_\_\_ Ft. from E. Line

330 Ft. from W. Line

SW SW SW

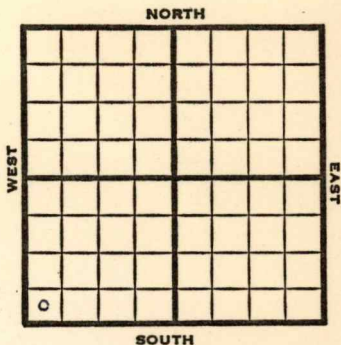

1951

Elev. 1522'

REPORT

4/25

Location

6/27

Spud 6-6-51

D & A

TD 2856'

8" @ 65'

KC 2067'

Miss 2801-56' TD

D & A

**ABANDONED**



