

Section 31 Township 18 Range 7W

Well No. #6 J. Powell

Company Continental Oil

NORTH

	0						

WEST

EAST

SOUTH

Rice

KANSAS

SEC.	TWP.	R.
31	18	7 W ✓

WELL NO.

# 6 J. Powell

FARM

COMPANY

Continental Oil

CONTRACTOR

L &amp; J

Geneseo Pool


990 Ft. from N. Line

Ft. from S. Line

Ft. from E. Line

990 Ft. from W. Line

SE NW NW

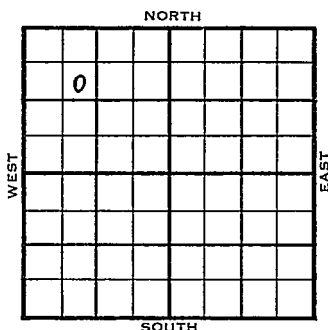

	ELEVATION	REPORT
1953	1705'	
12/30		Spud 12-23-53 8" @ 325 Dr1g. 2942'
1954		
1/27		Spud 12-23-53 Oil Well TD 3245' 8" @ 325' Heeb 2606', Br. Lime 2734', Lans 2765' DST 2934'-47' opn 1 hr, rec 10' hocm. 20' socm, 150# Simp 3155' DST 3158'-75' opn 1 hr, rec 19' Mud off Arb 3218' DST 3220'-25' opn 1 hr, rec 90' o & gc 1530' SW 850# TD 3245' 5" @ 3244' CO to 3208' 84/ 3175-3203 27/ 3158-67 1/3 bo 1/3 bw ph 14 hr. sd-oil-frac S/ 10 bo 1 bwph 8 hr. P/ 74 bo 49 bwph Comp 187 bopd 10% wtr.

COMPLETED



