

Ellis


KANSAS

SECTION 17 TOWNSHIP 14 RANGE 19W

WELL NO. #1 Kramer "A"

COMPANY Sterling Drlg. Co.

NORTH

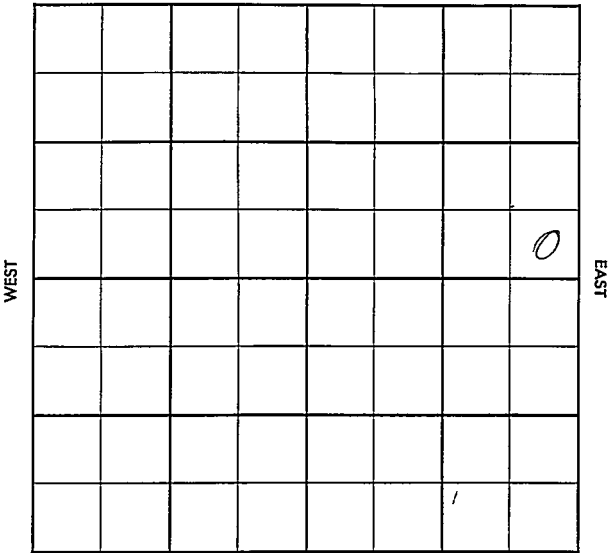

SOUTH

County Ellis

Elev. \_\_\_\_\_

Sec. 17 Twp. 14 Rge. 19WCompany Sterling Drlg. Co.FarmName Kramer "A" No. 1

TOPS

DEPTH

LOG

DATUM

Loc. in Sec. \_\_\_\_\_

Anh. \_\_\_\_\_

SE SE NE

Tp. \_\_\_\_\_

H. \_\_\_\_\_

Tr. \_\_\_\_\_

Dg. \_\_\_\_\_

Bl. \_\_\_\_\_

L. \_\_\_\_\_

K.C. \_\_\_\_\_

B.K.C. \_\_\_\_\_

Ce. \_\_\_\_\_

C. \_\_\_\_\_

M. \_\_\_\_\_

M. \_\_\_\_\_

K. \_\_\_\_\_

Mz. \_\_\_\_\_

Me. \_\_\_\_\_

V. \_\_\_\_\_

S. \_\_\_\_\_

S. \_\_\_\_\_

A. \_\_\_\_\_

R. \_\_\_\_\_

Pe. \_\_\_\_\_

G. \_\_\_\_\_

T.D. \_\_\_\_\_

Geol. \_\_\_\_\_

Cont. \_\_\_\_\_

Co. Tools \_\_\_\_\_

Pool KAUS

Irvin

FIRST REPORT

OFFICE

DEC 19 58

Date Comm. \_\_\_\_\_

C &amp; P

14



1hr 3' oil + 9' md BHP

1025/20" 5 1/2 @ 3820/75 FEB 13 '57

FEB 20 '57 CO. 3822 1st 2 GO +

6 CW in 1hr 10 Gal acid

FU 95' oil + 7' wt ~~450'~~ 13hr ~~1/4~~ & FU 950' Fluid

in 13 hr &amp; 1.78 Bopd

4 hr &amp; 250' O.B. "

YTD 6 3/4 80P MAR 13 '57 MAY - J '57

Ph P. 45 Bopd no/wt  
grav 40°