
DX 78-1

Rice KANSAS

Section 31 Township 18 Range 7W

Well No. 9 Powell

Company Continental Oil

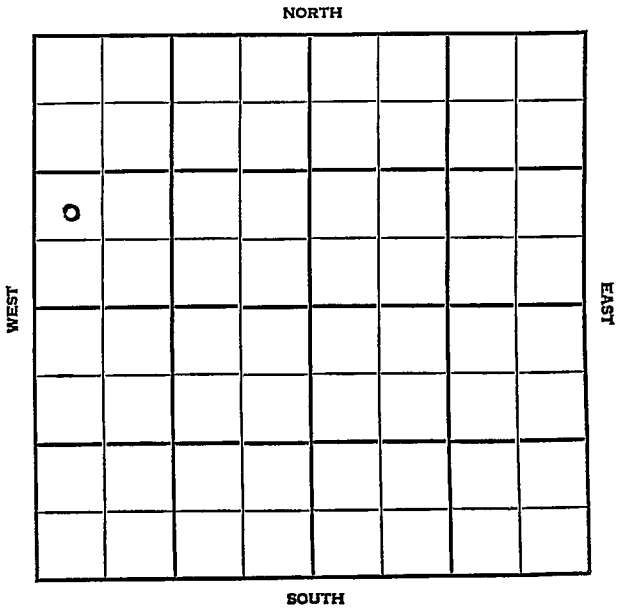

Rice KANSAS

SEC.	TWP.	R.
31	18	7W

WELL NO
9 Powell FARM

COMPANY
Continental Oil

CONTRACTOR
L & J

Geneseo-Edwards


_____ Ft. from N. Line

990 Ft. from S. Line

_____ Ft. from E. Line

330 Ft. from W. Line

NW SW NW

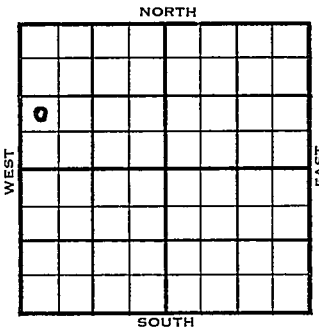

1955	ELEVATION REPORT
3/9	Spud 3-7-55 8" @ 301', WOC
6/8	Comm 3-7-55 8" @ 301/175, DST 3209-30, open 1 hr. Rec. 360' msw 240/20", TD 3308, 5½" @ 3307/200 15/3202-08, B/3/4 bw ½ hr. frac.PB3198, 18/3190-96, 500 M-A frac CO 3210 P/4 bo 24 hr. Comp. 7 bopd. 140 bw.

tops;	depth	log	datum
H.	2642	2638	915
BL	2773	2769	1046
L.	2805	2801	1078
BKC	3114	3110	1387
C.	3163	3159	1436
S.	3207	3187	1464
A.	3258	3250	1527
TD.	3269	3308	

COMPLETED

DX-78

FORM 275 FOR SALE BY KANSAS BLUE PRINT CO


County Rice State Kansas

Sec. 31 (Blk. Twp.) 18 (Sur. Rge.) 7W Map No.

Operator Continental Oil

Well No. 9 Farm Powell

Elev. Location NW SW NW

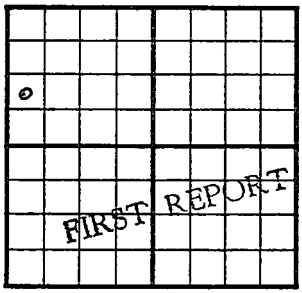

990 Ft. From S Line NW Quarter

330 Ft. From W Line

1st. Report MAR 9 1955

Completion

Remarks

L & J - Contr.

Spudding Date 3-7-55

Drlg. Data Geneseo-Edwards Pool

8" @ 301 WOC

FABEN GILSTRAP

FORM 513 REV. SUNRAY

County Rice Elev. 1723

Sec. 31 Twp. 18 Rge. 7W

Company Continental Oil

Farm Name Powell No. 9

TOPS	DEPTH	LOG	DATUM
Anh.			
Tp.			
H.	2642	2638	915
Tr.			
Dg.			
Bl.	2773	2769	1046
L.	2805	2801	1078
K.C.			
B.K.C.	3114	3110	1387
Ce.			
C.	3163	3159	1436
M.			
M.			
K.			
Mz.			
Mc.			
V.			
S.	3207	3187	1464
S.			
A	3258	3250	1527
R.			
Pe.			
G.			
T.D.	3269	3308	

Loc. in Sec. NW SW NW

Geol.

Contr. L & J

Lse.

Pool Geneseo-Edwards

No.

COMPLETE

JUN 8 1955

Date Comm. 3-7-55

Sec.

8" @ 301/175 DST 3209-30 open 1 hr.

Rec. 360' msw 240/20" TD 3308

T.

5½" @ 3307/200 15/ 3203-08 B/ 3/4 bw

½ hr. frac PB 3198 18/ 3190-96

500 M-A frac Co 3210 P/ 4 bo 24 hr.

Comp. 7 bopd 140 bw

R.