


Rice

Section 31 Township 18 Range 7-W

Well No. 1 J. Powell

Company Continental

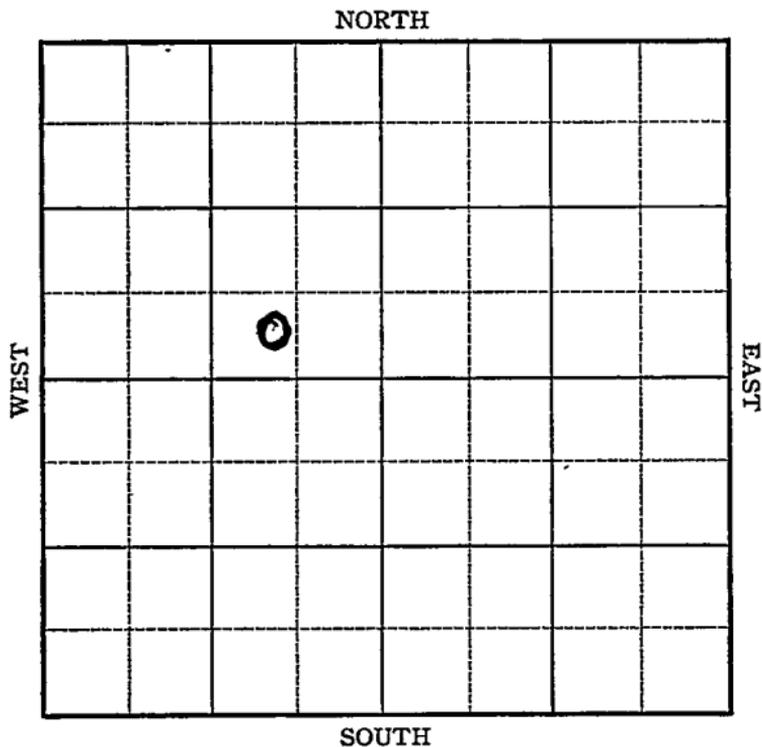



Sec. 31 Twp. 18 R. 7-W

Well No. #1 J. Powell Farm

Continental Company

*SW SE NW*


         Ft. from N. Line

330 Ft. from S. Line

750 Ft. from E. Line

         Ft. from W. Line

Elev. 1730

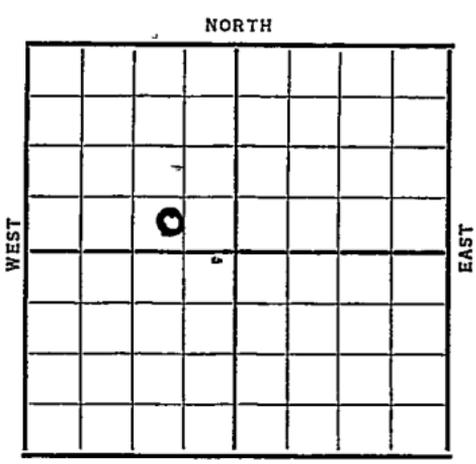

*LOHMAN & JOHNSON*

Date	REPORT
1937	
6/2	B.R.R.
6/11	10" @ 199'. Drlg. 922'.
6/19	DrLg. 3145'.
6/25	Sil. 3228'. 7" @ 3230'.
	T.D. 3233'. RUST.
7/2	Corrections: Sil. 3323'.
	7" @ 3325'. T.D. 3329'.
7/9	Correction-Sil. 3223-3230' bT.D
	Swab 315 bbls. oil 12 hrs.
	2000 acid.
7/16	Pumped 588 bbls. 24 hrs.
	2000 acid.
7/21	Sil 3223' (corrected)
	7" @ 3225'
	TD 3230'
	2000 acid
	2000 acid
	Pot 933

**OVER**

**COMPLETED**

O.W.W.O.

1954  
8/11

Oil Well - TD 3275'  
Simp. 3174', Arb. 3223'  
OTD 3275'  
PB 3239'  
4" @ 3274'  
57/3193-3212'  
Sd-oil-frac  
S/5½ bo 1 bwph 6 hrs.  
C omp. 57 bopd 57 bw

FIRST REPORT

✓  
COMPLETED



Rice

Map No. 45 Sec. 31 Twp. 18 R. 7<sup>W</sup>Well No. 1 - PowellContinental Company

Contractor

## COMPLETED

## SECTION PLAT

	0		

\_\_\_\_\_ Ft. from N. Line

330 Ft. from S. Line750 Ft. from E. Line

\_\_\_\_\_ Ft. from W. Line

Location \_\_\_\_\_

Rig up \_\_\_\_\_

Drilling and Remarks:

2000 Acid  
2000 ✓

Pot - 933

## RECORD

Cased 7 in., 3225 ft.Sand 511 3223Gas (Corrected)

Oil \_\_\_\_\_

Total Depth 3230

## PRODUCTION

1st 24 hrs. Nat. \_\_\_\_\_

1st 24 hrs. after shot \_\_\_\_\_

Gas \_\_\_\_\_ Cu. Ft.

Dry Hole \_\_\_\_\_

Abandoned \_\_\_\_\_

Date

JUL 21 1937 '19 H. D. Hatfield Scout

O.W.W.O.

County Rice State Kansas

Sec. 31 (Blk. 18 (Sur. 7W (Twp. 18 (Rge. 7W Map No.

Operator Continental Oil

Well No. 1 Farm J. Powell

Elev. 1730 Location SW SE NW

	FIRST	REPORT			
	o				
	COMPLETE				

2310 Ft. From N Line NW

1890 Ft. From W Line Quarter

1st. Report AUG 11 1954

Completion O.W.W.O. 11 1954

Remarks OWWO

Lohman & Johnson - Contr.

Spudding Date

Drlg. Data Oil well TD 3275

Simp. 3174 Arb. 3223 OTD 3275

PB 3239 4" @ 3274 57/ 3193-3212

sd-oil-frac S/ 5 1/2 bo 1 bwph 6 hr.

Comp. 57 bopd 57 bw

72