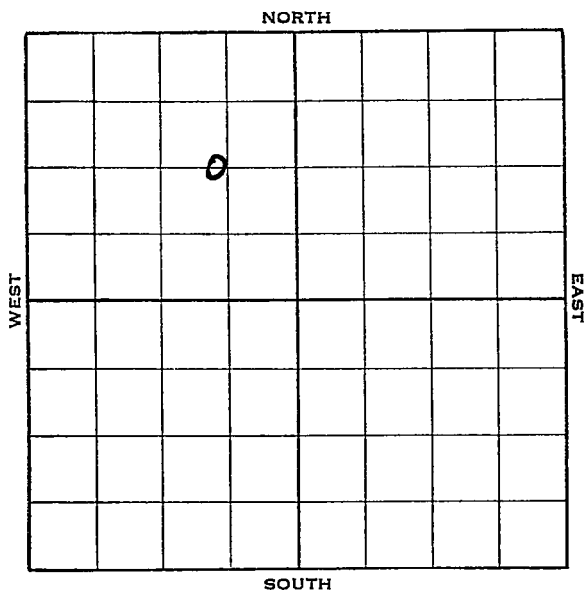


Section 31 Township 18 Range 7-WWell No. #2 J. PowellCompany Continental

Sec. 31 Twp. 18 R. 7-WWell No. #2 J. Powell Farm

Continental Company

Genesee-Edwards Pool

NORTH


1320 Ft. from N. Line

Ft. from S. Line

750 Ft. from E. Line1890 Ft. from W. Line

C W/2 E/2 NW

Elev. 1729

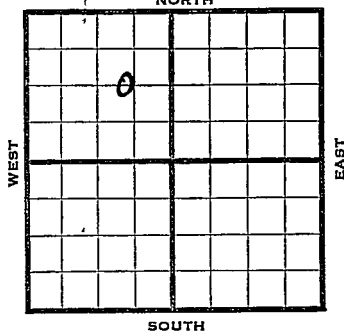

1938	REPORT
4/13	Cellar.
4/22	10" @ 207'. WOC.
4/29	Drlg. 2730'.
5/6	Arb. 3221'. 7" at 3222'.
	Drlg. 3226'. 750' oil.
5/12	T.D. 3228'. 1400' oil.
	3000 acid.
5/18	7" @ 3222'.
	Arb. 3221'.
	T.D. 3228'.
	1000 acid.
	2000 acid.
	Potential 930 bbls.
	COMPLETED
1955	O. W. P. B.
6/29	7" @ 3222 Sq 52/3184-3204
	24/3188-94 B/1 GO $\frac{1}{2}$ BWPB 4 hr.
	sd-frac. Comp. 37 BOPD 106 BW
	S. 3168' A. 3221' TD 3228'
	FIRST REPORT

COMPLETED

Rice

KANSAS

Map No. 45 Sec. 31 Twp. 18 R. 7WWell No. 2 J. PowellContinental

Company

Contractor

FIRST REPORT

Approx
C $E\frac{1}{2}$ NW1320 Ft. from N. Line Ft. from S. Line750 Ft. from E. Line Ft. from W. Line

SECTION PLAT

	0		

Location Rig up Drilling and Remarks:
Cellar

RECORD

Cased in., ft.Sand Gas Oil Total Depth

PRODUCTION

1st 24 hrs. Nat. 1st 24 hrs. after shot Gas Cu. Ft.Dry Hole Abandoned

Date

APR 13 1938 19

H. D. Hatfield

Scout

Rice

KANSAS

Map No. 45 Sec. 31 Twp. 18 R. 7WWell No. 2 J. PowellContinental

Company

Contractor

~~COMPLETED~~

Approx.

C E $\frac{1}{2}$ NW1320 Ft. from N. Line Ft. from S. Line750 Ft. from E. Line Ft. from W. Line

SECTION PLAT

	0		

Location Rig up

Drilling and Remarks:

1000 acid
2000 ✓

Rot 930

RECORD

Cased 7 in. 3222 ft.Sand Ark. 3221Gas Oil Total Depth 3228

PRODUCTION

1st 24 hrs. Nat. 1st 24 hrs. after shot Gas Cu. Ft.Dry Hole Abandoned

Date

MAY 18 1938

19

H. D. Hatfield Scout

O. W. P. B.

FORM 513 REV. SUNRAY

OWPB

County Rice Elev. 1729
 Sec. 31 Twp. 12 Rge. 7W
 Company Continental Oil
 Farm Name J. Powell No. 2

TOPS

DEPTH

LOG

DATUM

Loc. in Sec.

Anh.				C $W\frac{1}{2}$ E $\frac{1}{2}$ NW
Tp.				
H.				
Tr.				
Dg.				1320' NL
BL.				1890' WL
L.				
K.C.				Geol.
B.K.C.				Contr.
Ce.				
C.				
M.				
M.				Pool
K.				Geneseo-Edwards
Mz.				
Ms.				
V.				
S.	3168		1439	JUN 29 '55
S.				
A.	3221			
R.				
Pe.	PF		1459-65	
G.	7"		1493	
T.D.	3228			

Date Comm.

7" @ 3222 sq. 52/ 3184-3204

24/ 3188-94 B/ 1 go $\frac{1}{2}$ bwph 4 hr.

sd-frac Comp. 37 bopd 106 bw

FIRST REPORT
COMPLETE