


Section 2 Township 28 Range 7 E

Well No. #1 Farner

Company Adair & Morton

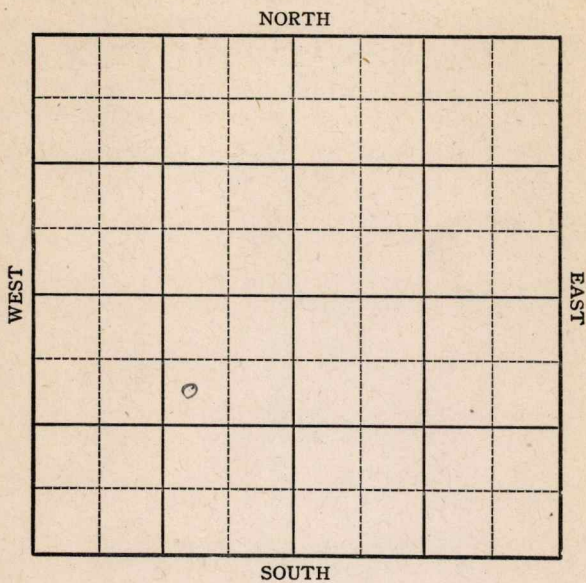

**KANSAS**

Butler

Sec. 2 Twp. 28 R. 7-E

Well No. #1 Farner Farm

Adair & Morton Company


990 Ft. from N. Line

\_\_\_\_\_ Ft. from S. Line

990 Ft. from E. Line

\_\_\_\_\_ Ft. from W. Line

Elev. 1504

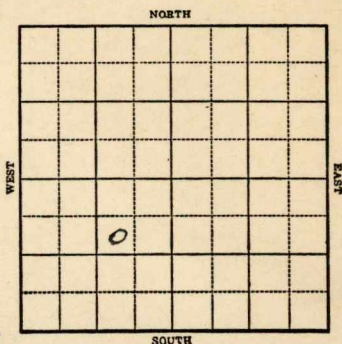

1943

R E P O R T

<p>12/1 12/8 12-15  12/22  12/29 1944 1-5  1/12</p>	<p>Cable Drlg. 350' 12" at 775' Drlg. 1050'  <b>Lans 1735</b> Drlg. 1930 Drlg 2250'  <b>Miss 2776</b> TD 2801. 2 oil &amp; 1 water in 11 hours. 6" @ 2784 PB 2796- 700' oil in 48 hrs.  6" @ 2784 <b>Miss 2776</b> TD 2801 PB 2796 2500 acid Pump 125 Pot. Gravity 36.3  <b>COMPLETED</b></p>
---	---

KANSAS

Map No. 10 Sec. 2 Twp. 28 R. 7E

Well No. 1 Farner

Adair & Morton Company

**COMPLETED**

Contractor

SW NE SW

SECTION PLAT

990 Ft. from N. Line

\_\_\_\_\_ Ft. from S. Line

990 Ft. from E. Line

\_\_\_\_\_ Ft. from W. Line

	6		

Miscellaneous

Location \_\_\_\_\_

Rig up \_\_\_\_\_

Drilling and Remarks:

*Miss 2776*  
*6" @ 2784*  
*PB 2796*  
*2500 acid*  
*Aug 125 Prt.*  
*36<sup>3</sup> GN*

RECORD

Cased \_\_\_\_\_ in., \_\_\_\_\_ ft.

Sand \_\_\_\_\_

Gas \_\_\_\_\_

Oil \_\_\_\_\_

Total Depth 280

PRODUCTION

1st 24 hrs. Nat. \_\_\_\_\_

1st 24 hrs. after shot \_\_\_\_\_

Gas \_\_\_\_\_ Cu. Ft.

Dry Hole \_\_\_\_\_

Abandoned \_\_\_\_\_

Date

JAN 12 1944

19

S. J. LEWIS

Scout

KANSAS

Map No. 16 Sec. 2 Twp. 28 R. 7E

Well No. 1 Farner

Adair & Morton Company

FIRST REPORT Contractor

SW NE SW


SECTION PLAT

990 Ft. from N. Line

\_\_\_\_\_ Ft. from S. Line

990 Ft. from E. Line

\_\_\_\_\_ Ft. from W. Line

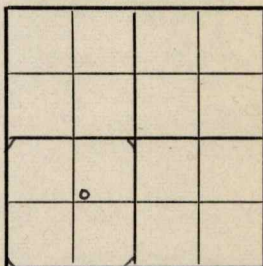

Miscellaneous

Location \_\_\_\_\_

Rig up \_\_\_\_\_

Drilling and Remarks:

Cable

RECORD

Cased \_\_\_\_\_ in., \_\_\_\_\_ ft.

Sand \_\_\_\_\_

Gas \_\_\_\_\_

Oil \_\_\_\_\_

Total Depth \_\_\_\_\_

PRODUCTION

1st 24 hrs. Nat. \_\_\_\_\_

1st 24 hrs. after shot \_\_\_\_\_

Gas \_\_\_\_\_ Cu. Ft.

Dry Hole \_\_\_\_\_

Abandoned \_\_\_\_\_

Date

DEC 1 1943 19

S. J. LEWIS Scout