


Rice

Section 31 Township 18 Range 7-W

Well No. 1 Prochaske

Company Empire

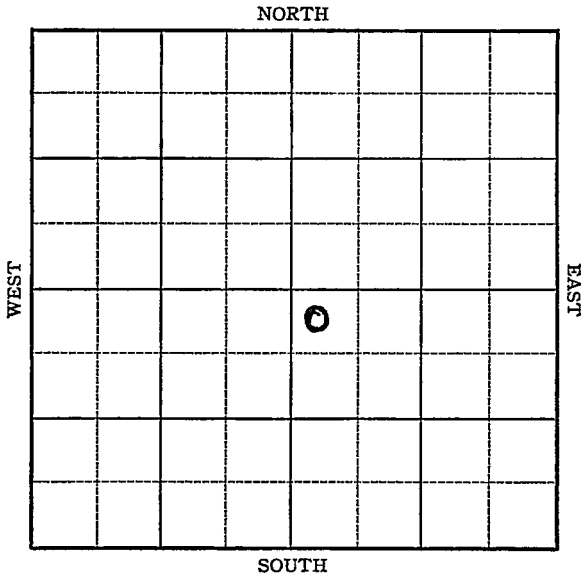

Sec. 31 Twp. 18 R. 7-V

Well No. #1 Prochaske Farm

Empire Company


330 Ft. from N. Line

_____ Ft. from S. Line

_____ Ft. from E. Line

250 Ft. from W. Line

Elev. 1710

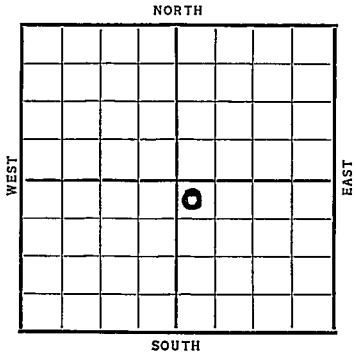

Date	REPORT
1937	
5/26	Location
6/4	R. R.
6/11	12" @ 188'. WOC.
6/19	Drlg. 2650'.
6/23	Sil. 3239'.
	T.D. 3249'.
	COMPLETED ABANDONED

Rice KANSAS

Map No. _____ Sec. 31 Twp. 18 R. 7^W

Well No. 1 - Prochaska

Empire Company

Contractor _____

FIRST REPORT

SECTION PLAT

330 Ft. from N. Line
 _____ Ft. from S. Line
 _____ Ft. from E. Line
250 Ft. from W. Line

		0	

Location ✓

Rig up _____

Drilling and Remarks:

RECORD

Cased _____ in., _____ ft.

Sand _____

Gas _____

Oil _____

Total Depth _____

PRODUCTION

1st 24 hrs. Nat. _____

1st 24 hrs. after shot _____

Gas _____ Cu. Ft.

Dry Hole _____

Abandoned _____

Date _____

MAY 26 1937 19 H. D. Hatfield Scout

Rice KANSAS

Map No. 45 Sec. 31 Twp. 18 R. 7^WWell No. 1 - ProchaskaEmpire Company

Contractor

ABANDONED

SECTION PLAT

330 Ft. from N. Line

_____ Ft. from S. Line

_____ Ft. from E. Line

250 Ft. from W. Line

		0	

Location _____

Rig up _____

Drilling and Remarks:

DVA

RECORD

Cased _____ in., _____ ft.

Sand 511 3239

Gas _____

Oil _____

Total Depth 3249

PRODUCTION

1st 24 hrs. Nat. _____

1st 24 hrs. after shot _____

Gas _____ Cu. Ft.

Dry Hole _____

Abandoned _____

Date

JUN 23 1937 19

H. D. Hatfield

Scout