

KANSAS

*Price*

FORM 51 25M 3-49 PETROL

Section 32 Township 18 Range 7-W

Well No. #1 Gray

Company Heathman Drlg

NORTH

0							

WEST

EAST

SOUTH

Sec. 32 Twp. 18 R. 7-W ✓

Well No. #1 Gray Farm \_\_\_\_\_


Heathman Drlg Company  
B & B Dont.

330 Ft. from N. Line

\_\_\_\_\_ Ft. from S. Line

\_\_\_\_\_ Ft. from E. Line

330 Ft. from W. Line

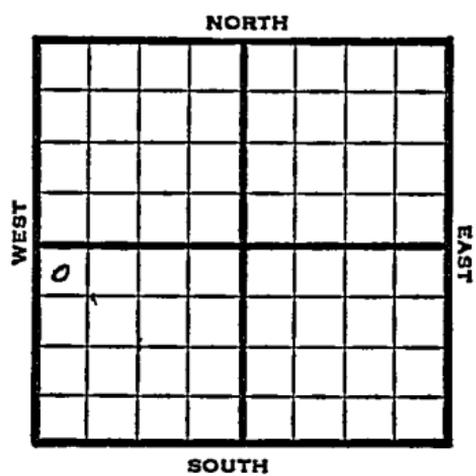

NW NW SW

1950

Elev 1708' REPORT

2/22  
3/8

MIM  
 TD 3316'  
 8 5/8" @ 155'  
 Lans 2791'  
 Cong 3169'  
 Viola 3210'  
 Simp 3246  
 Arb. 3306'  
 D&A  
 Aband

**ABANDONED**

Map No. \_\_\_\_\_ Sec. 32 Twp. 18 R. 7W

Well No. 1 Gray

Heathman Drlg. Company

B & B Contractor

NW NW SW


330 Ft. from N. Line

\_\_\_\_\_ Ft. from S. Line

\_\_\_\_\_ Ft. from E. Line

330 Ft. from W. Line

SECTION PLAT

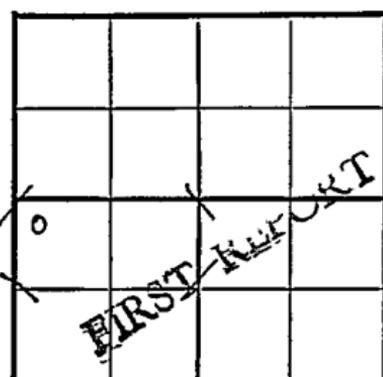

Rice County

Location \_\_\_\_\_

Rig up \_\_\_\_\_

Drilling and Remarks:

M I M

RECORD

Cased \_\_\_\_\_ in., \_\_\_\_\_ ft.

Sand \_\_\_\_\_

Gas \_\_\_\_\_

Oil \_\_\_\_\_

Total Depth \_\_\_\_\_

PRODUCTION

1st 24 hrs. Nat. \_\_\_\_\_

1st 24 hrs. after shot \_\_\_\_\_

Gas \_\_\_\_\_ Cu. Ft.

Dry Hole \_\_\_\_\_

Abandoned \_\_\_\_\_

Date

FEB 22 1950 19

J. E. TYRA Scout

Map No. \_\_\_\_\_ Sec. 32 Twp. 18 R. 7W

Well No. 1 Gray

\_\_\_\_\_ Heathman Drlg. \_\_\_\_\_ Company

\_\_\_\_\_ Contractor

NW NW SW

*El. 1708*  
SECTION PLAT

330 Ft. from N. Line

\_\_\_\_\_ Ft. from S. Line

\_\_\_\_\_ Ft. from E. Line

330 Ft. from W. Line

ABANDONED			
o			

Rice County

Location \_\_\_\_\_

Rig up \_\_\_\_\_

Drilling and Remarks:

*8 5/8 @ 155*

*Lans 2791*

*cong 3169*

*Viola 3210*

*Simp 3246*

*Arb 3306*

RECORD

Cased \_\_\_\_\_ in., \_\_\_\_\_ ft.

Sand \_\_\_\_\_

Gas \_\_\_\_\_

Oil \_\_\_\_\_

Total Depth 3316

PRODUCTION

1st 24 hrs. Nat. \_\_\_\_\_

1st 24 hrs. after shot \_\_\_\_\_

Gas \_\_\_\_\_ Cu. Ft.

Dry Hole \_\_\_\_\_

Abandoned \_\_\_\_\_

Date

*D + A*

J. E. TYRA

MAR 8 1950 19

Scout