


DX 78-1 RICE

KANSAS

Section 31 Township 18 Range 7W

Well No. 8 J. Powell

Company Continental Oil

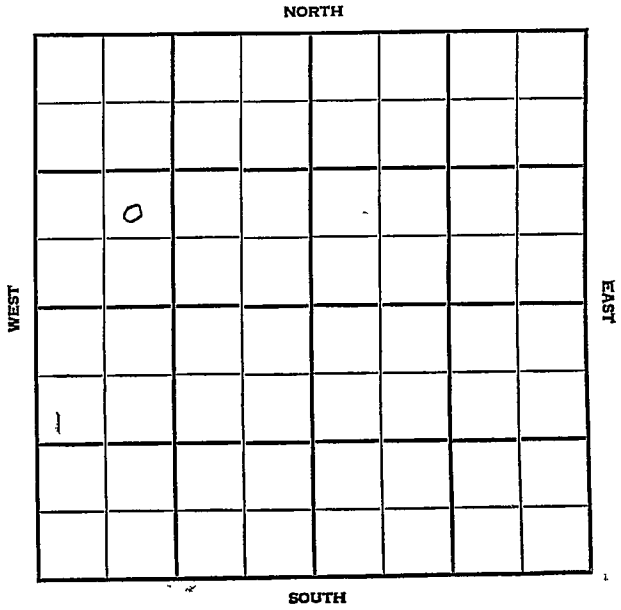

Rice

KANSAS

SEC.	TWP.	R.
31	18	7W

WELL NO.

#8 J. Powell

FARM

COMPANY

Continental Oil

CONTRACTOR

Lohman & Johnson

Geneseo Pool

NORTH

_____ Ft. from N. Line

990 _____ Ft. from S. Line

_____ Ft. from E. Line

990 _____ Ft. from W. Line

	o						

WEST

EAST

SOUTH

NE SW NW

1955	ELEVATION	REPORT
	1729	

3/30

spud 3-27-55

8" @ 308'

Drlg. 1148'

8/3

Comm 3-27-55

H 2640

BL 2770

L 2802

S 3201

A 3261

TD 3264

8" @ 308/175 5 1/2" @ 3263/75

CO to 3249 12/3219-22 B/1 gw ph

5 hr frac sq perf 3219-22

CO to 3244 4/3220-22 7/3222-24

B/4 go 4 hr. P/1/5 bo 4 hr frac

sq perf 4220-24 CO to 3249 36/3228-

40 B/6 go 1 1/2 bw 3 hr

D & A

ABANDONED

County Rice State Kansas

Sec. 31 (Blk. Twp.) 18 (Sur. Rge.) 7W Map No.

Operator Continental Oil

Well No. 8 Farm J. Powell

Elev. Location NE SW NW

990Ft. From S Line NW

990Ft. From W Line Quarter

Ist. Report MAR 30 1955

Completion

Remarks

Lohman & Johnson - Contr.

Spudding Date 3-27-55

Drlg. Data Geneseo Pool

8" @ 308 drlg. 1148

FABEN GILSTRAP

County Rice Elev. 1729
 Sec. 31 Twp. 18 Rgs. 7W
 Company Continental Oil
 Farm Name J. Powell No. 8

TOPS	DEPTH	LOG	DATUM	Loc. in Sec.
Anh.				NE SW NW
Tr.				
H.		2640	911	
Dg.				
Bl.		2770	1041	
L.		2802	1073	Geol.
K.C.				
B.K.C.				Contr.
Ce.				I & J
C.				
M.				Pool
M.				Geneseo
K.				
Mz.				
Me.				
V.				
S.		3201	1472	
S.				
A.		3261	1532	
R.				
PE.				
G.				
T.D.	3264			

Date Comm. 3-27-55 AUG 3 1955

8" @ 308/175 5 1/2" @ 3263/75
 CO to 3249 12/ 3219-22 B/ 1 gw ph
 5 hr. frac sq. perf. 3219-22
 CO to 3244 4/ 3220-22 7/ 3222-24
 B/ 4 go 4 hr. P/ 1/5 bo 4 hr. frac
 sq perf. 4220-24 CO to 3249 36/ 3228-40
 B/ 6 go 1 1/2 bw 3 hr.
 D & A