


Section 31 Township 18 Range 7 W

Well No. # 1 Prochaska

Company J. C. Dozier

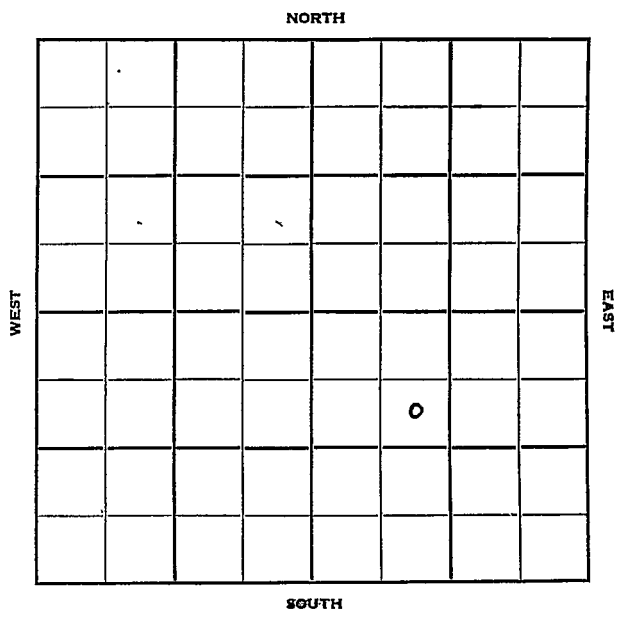

Rice

KANSAS

Sec. 31 Twp. 18 R. 7W

Well No. #1 Prochaska Farm

J. C. Dozier Company

Contractor

Geneseo Pool


990' Ft. from N. Line

_____ Ft. from S. Line

_____ Ft. from E. Line

990' Ft. from W. Line

SE NW SE

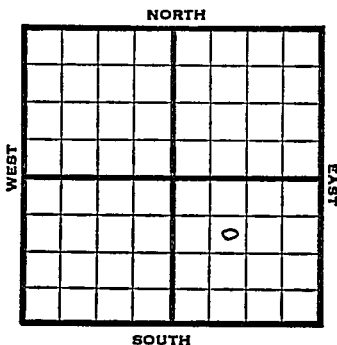

1951.

Elev. 1737' REPORT

2/21

Location

3/21

Spud date 3-3-51

D&A TD 3205

8" @ 210

Heeb. 2656 Br Line 2782

Lans. 2816 Cong. 3190

Viola 3229 Simp 3249

TD 3255' 5" @ 3249

DD 3270 SP 3220

46/3189-3205

D&A

ABANDONED

