

KANSAS

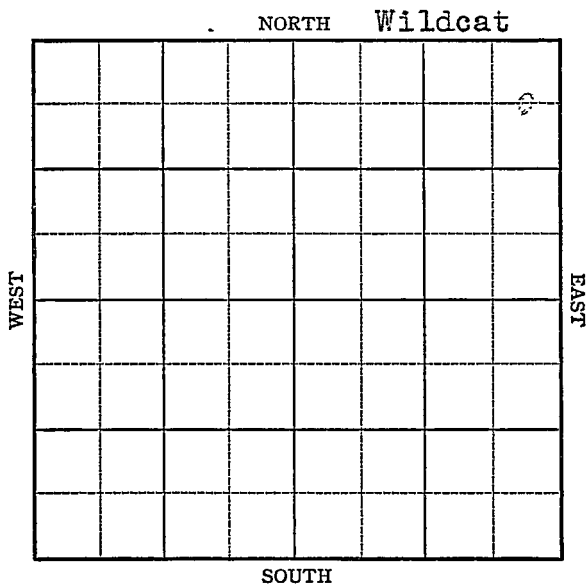
Ellis

FORM 51 5M 10-41 PETROL

Section 5 Township 14 Range 19-W

Well No. #1 Orth

Company Sharon Drilling



KANSAS

Ellis

Sec. 5 Twp. 14 R. 19-W

Well No. #1 Orth Farm

Sharon Drilling _____ Company

(Wildcat)

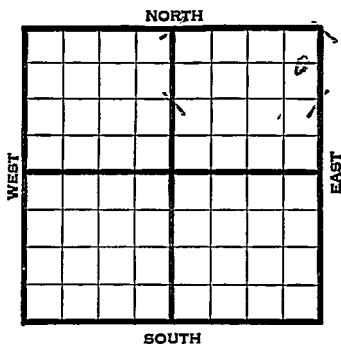
660 Ft. from N. Line

Ft. from S. Line

330 Ft. from E. Line

Ft. from W. Line

Elev. 2268

[illegible]

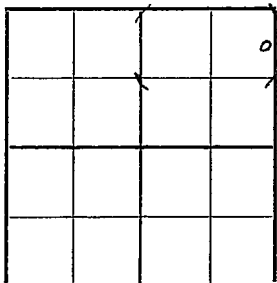
Ellis **KANSAS**Map No. 70 Sec. 5 Twp. 14 R. 19WWell No. 1 OrthSharon Drilling

Company

FIRST REPORT

Contractor

C E L N E N E

660 Ft. from N. Line Ft. from S. Line330 Ft. from E. Line Ft. from W. Line**SECTION PLAT****WILDCAT****RECORD**Location XXCased in., ft.Rig up Sand

Drilling and Remarks:

Gas Oil Total Depth **PRODUCTION**1st 24 hrs. Nat. 1st 24 hrs. after shot Gas Cu. Ft.Dry Hole Abandoned

Date

MAR 1 1 1942 19S. J. LEWIS

Scout

Map No. 70 Sec. 5 Twp. 14 R. 19WWell No. 1 OrthSharon Drilling Company**ABANDONED**

Contractor

C EL NE NE

SECTION PLAT

660 Ft. from N. Line Ft. from S. Line330 Ft. from E. Line Ft. from W. Line

WILDCAT

Location Rig up

Drilling and Remarks:

*CR X 3897**5" @ 3954**Water.*

RECORD

Cased in., ft.Sand Gas Oil Total Depth 3962

PRODUCTION

1st 24 hrs. Nat. 1st 24 hrs. after shot Gas Cu. Ft.Dry Hole Abandoned

Date

APR 22 1942 19 S. J. LEWIS Scout