

Rice

Map No. KANSAS Sec. 1 Twp 18 R. 8^W

Well No. 1 Holmer Farm


Yingling et al Company

_____ Ft. from N. Line

990 Ft. from S. Line

_____ Ft. from E. Line

330 Ft. from W. Line

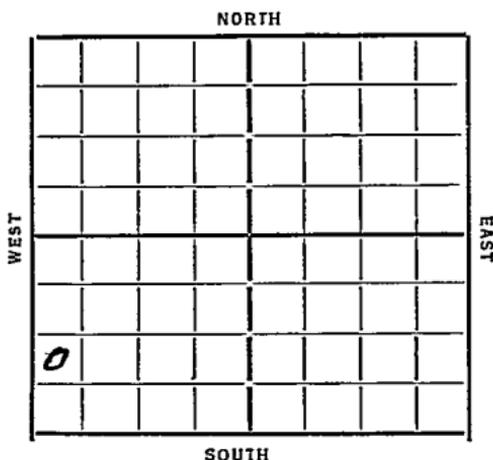

Date 1954

REPORT

<u>7/18</u>	<u>Location</u>
<u>7/26</u>	<u>—</u>
<u>8/2</u>	<u>Rgn</u>
<u>8/9</u>	<u>—</u>
<u>8/16</u>	<u>slg 252</u>
<u>8/23</u>	<u>" 885</u>
<u>8/30</u>	<u>" 1255 12 1/2 1150</u>
<u>9/6</u>	<u>" 1890</u>
<u>9/13</u>	<u>" 2430 10" 2060</u>
<u>9/20</u>	<u>2620 seg</u>
<u>9/27</u>	<u>— 10/4 — 10/11 — 10/18 —</u>
<u>10/25</u>	<u>slg 2740</u>
<u>11/1</u>	<u>seg 2740</u>
<u>11/8</u>	<u>slg 2665</u>
<u>11/15</u>	<u>HFW 2775 8" 2775</u>
	<u>T7 2850</u>
<u>11/22</u>	<u>K.C.L. 2850 A.O. 2850-70</u>
	<u>HFW 2970-90</u>
<u>11/28</u>	<u>slg 3200 6 5/8 3026</u>
<u>12/6</u>	<u>6" 3233 T7 3238</u>
	<u>165' fluid 80% water</u>
	<u>— OVER —</u>

12/13 3237-40 1800' fluid
3245 Inc in water
PB 3239 Tubing
12/21 Pump 60 Bbls oil &
7 Water 12 hrs acidizing
12/27 — 1/3/35 —
1/10 60 Bbls per day Will Super
1/17 C.O
1/24 — 1/31 —
2/7 6" 3254 TD 3262 Bailing
2/13 Silicious 3340
TD 3354
HFWS 7.5 FT.

ABANDONED

ANSAS

Map No. 45 Sec. 1 Twp. 18 R. 8W

Well No. 1-Holmes

Yingling et al Company

~~FIRST REPORT~~

Contractor

SECTION PLAT

0			

_____ Ft. from N. Line

990 Ft. from S. Line

_____ Ft. from E. Line

330 Ft. from W. Line

Location ✓

Rig up _____

Drilling and Remarks:

RECORD

Cased _____ in., _____ ft.

Sand _____

Gas _____

Oil _____

Total Depth _____

PRODUCTION

1st 24 hrs. Nat. _____

1st 24 hrs. after shot _____

Gas _____ Cu. Ft.

Dry Hole _____

Abandoned _____

Date

7-18-34 19

ORVAL MANN SCHRECK Scout

Map No. 45 Sec. 1 Twp. 18 R. 8W

Well No. 1-Holmes

Mingling et al Company

Contractor

ABANDONED

SECTION PLAT

.....Ft. from N. Line

990 Ft. from S. Line

.....Ft. from E. Line

330 Ft. from W. Line

3			
0			

Location.....

Rig up.....

Drilling and Remarks:

H F W

NO + H

RECORD

Cased.....in.,ft.

Sand silicious 3340

Gas.....

Oil.....

Total Depth 3354

PRODUCTION

1st 24 hrs. Nat.....

1st 24 hrs. after shot.....

Gas.....Cu. Ft.

Dry Hole.....

Abandoned.....

Date

2-13-35 192

ORVAL MANNSCHRECK

Scout