


Section 13 Township 28 Range 6 E

Well No. # 1 McCraig

Company M.C. McClure & Rex & Morris

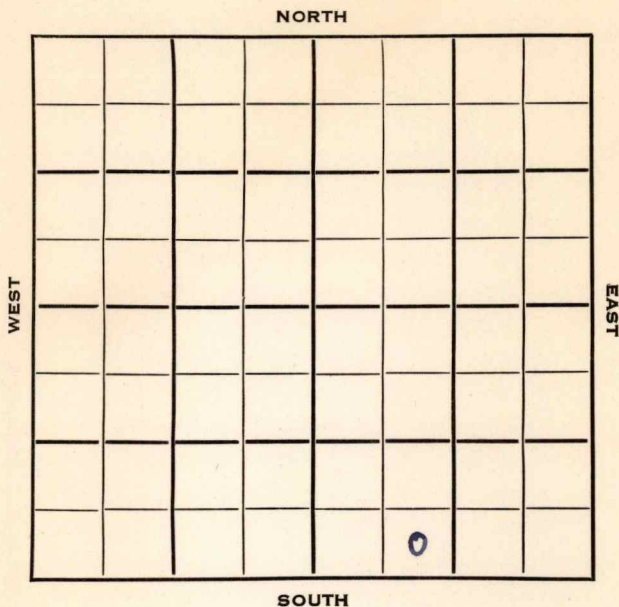

Butler

KANSAS ✓

Sec. 13 Twp. 28 R. 6E

Well No. #1 McCraig Farm

M. C. McClure & Rex & Morris Company

Contractor


Ft. from N. Line

330 Ft. from S. Line

Ft. from E. Line

990 Ft. from W. Line

SE SW SE

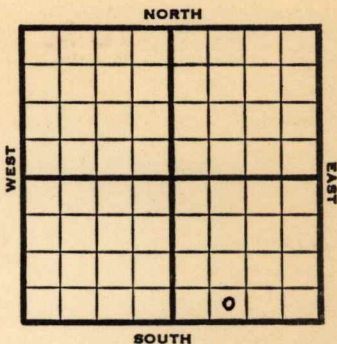

1952

REPORT

Elev. 1365'

12/3

Location

1953

1/28

Spud 12-6-52

D & A TD 2712' KC 2075' ~~XXXXXX~~

B KC 2258' Bart. 2644' Bart. sd

2694' TD 2699 5" @ 2699

DD 2712 S/200 BW S/5 BO 40 BWPH

Hydro. 200 BWPD

D & A

ABANDONED



