


Section 5 Township 14 Range 19-W

Well No. #1 Reidel

Company Derby  
Riedel Pool

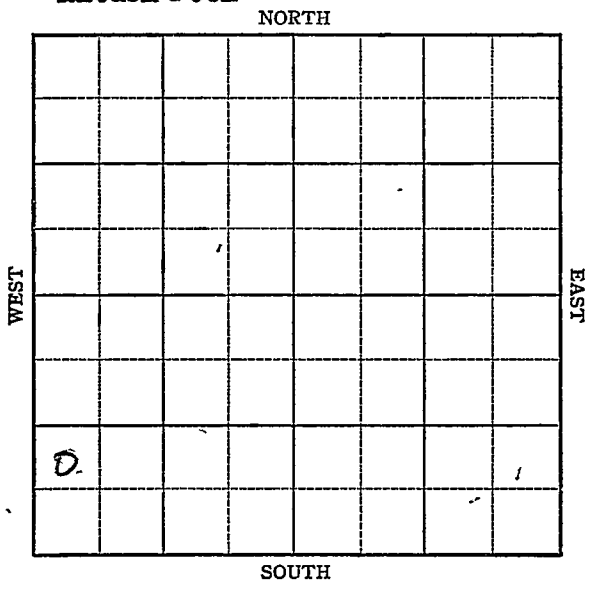

KANSAS

Ellis county

Sec. 5 Twp. 14 R. 19W

Well No. 1 Riedel Farm

Derby Company


Riedel Pool

990 Ft. from N. Line

\_\_\_\_\_ Ft. from S. Line

\_\_\_\_\_ Ft. from E. Line

330 Ft. from W. Line

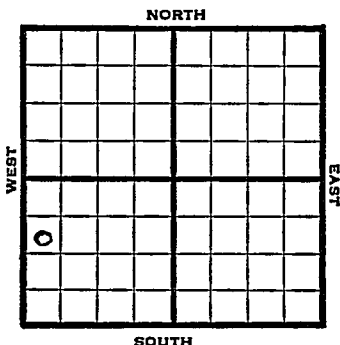

SW NW SW

1947 Elev 2285' REPORT

- 6/25 RUR
- 7/1 8" @ 1521'  
Drlg 2530'
- 7/8 Lansing 3508'  
Arbuckle 3842  
TD 3848  
5" @ 3843'
- 7-16 RUST  
TD 3848
- 7/22 T.D. 3850'  
Swb 50 bbls Oil
- 7/29 500 acid.
- 8/6 "
- 8/13 Arb. 3842'  
5" @ 3843'  
500 Acid.  
Pump 320 Pot.  
Gr. 27  
T.D. 38508  
Complete

COMPLETED

Map No. \_\_\_\_\_ Sec. 5 Twp. 14 R. 19W

Well No. 1 Riedel

Derby \_\_\_\_\_ Company \_\_\_\_\_

FIRST REPORT Contractor \_\_\_\_\_

SW NW SW

990 Ft. from N. Line

\_\_\_\_\_ Ft. from S. Line

\_\_\_\_\_ Ft. from E. Line

330 Ft. from W. Line

SECTION PLAT


Ellis County

Location \_\_\_\_\_

Rig up \_\_\_\_\_

Drilling and Remarks:

R U R

RECORD

Cased \_\_\_\_\_ in., \_\_\_\_\_ ft.

Sand \_\_\_\_\_

Gas \_\_\_\_\_

Oil \_\_\_\_\_

Total Depth \_\_\_\_\_

PRODUCTION

1st 24 hrs. Nat. \_\_\_\_\_

1st 24 hrs. after shot \_\_\_\_\_

Gas \_\_\_\_\_ Cu. Ft.

Dry Hole \_\_\_\_\_

Abandoned \_\_\_\_\_

Date

JUN 25 1947 19

S. J. LEWIS Scout

