


Section 2 Township 18 Range 8W

Well No. #1 Goodwin

Company Flourney & Williams

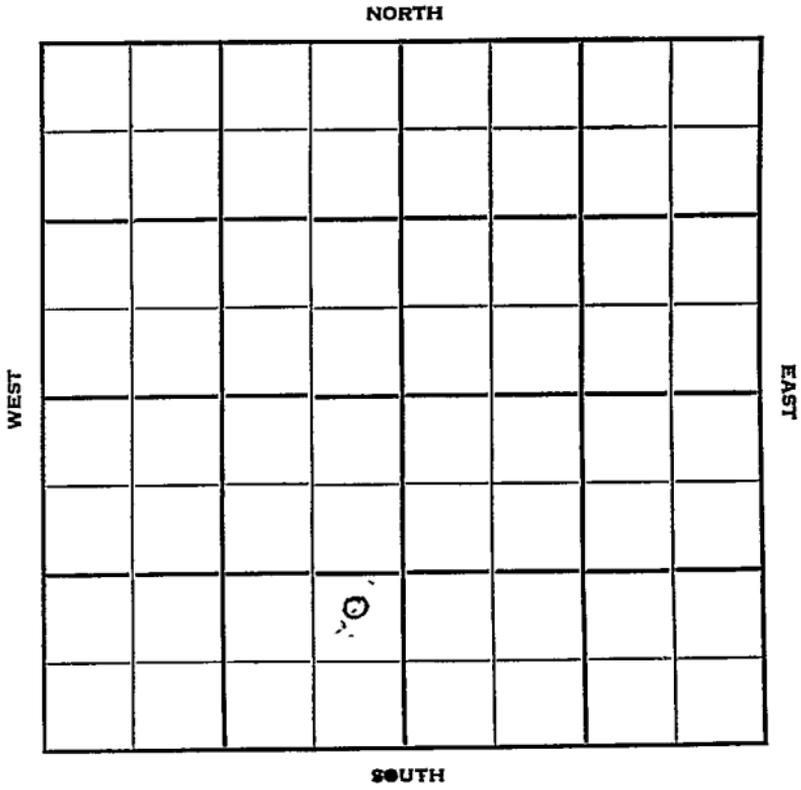

Rice

KANSAS

Sec. 2 Twp. 18 R. 8 W

Well No. # 1 Goodwin Farm

Flourney & Williams Company

Contractor


Ft. from N. Line

1040 Ft. from S. Line

330 Ft. from E. Line

Ft. from W. Line

NE SE SW

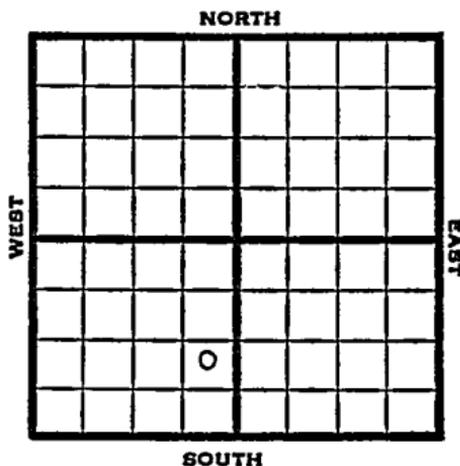

1951 Elev. 1771' REPORT

6/13 Spud 6-8-51
8" @ 217
Drlg. 1540'

8/1 Spud 6-8-51
Oil well TD 3234'
8" @ 217' Lans 2845' Cong 3210'
5" @ 3210' TD 3234' S/7 BOPH
Comp. 246 BOPD 4% water

COMPLETED

