


Butler
 Map No. **KANSAS** Sec. *35* Twp. *25*^S R. *4*^E
 Well No. *2 - Miller Creek* Farm
Tuloma Oil Company

NORTH

WEST

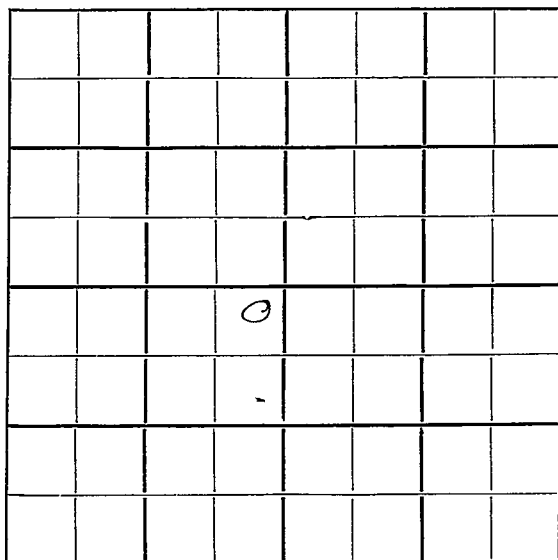

EAST

SOUTH

Location.....

Drilling Remarks

Rig Up.....

Drilling Remarks

RECORD

Cased.....in.....ft.

Sand.....

Gas.....

Oil.....

Total Depth.....

PRODUCTION

1st 24 hrs. Nat.....

1st 24 hrs. after shot.....

Gas.....cu. ft.....

Dry Hole.....

Abandoned.....

Map No. Sec. Twp. R.

Well No. Farm


..... Company

.....Ft. from N. Line

.....Ft. from S. Line

.....Ft. from E. Line

.....Ft. from W. Line

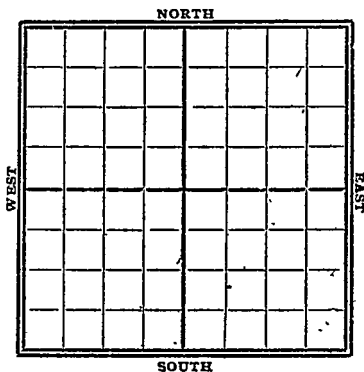

1926

Date

REPORT

Gypsy Records

11/29

Abd T.D. 1485'

K 14 MAP NO. KANSAS SEC. 35 TWP. 28S R. 4E

WELL NO. 2 Millerbeck
Inlome COMPANY

CONTRACTOR

ABANDONED

SECTION PLAT

	10		

_____ FT. FROM N. LINE

_____ FT. FROM S. LINE

_____ FT. FROM E. LINE

_____ FT. FROM W. LINE

RECORD

LOCATION _____

CASED _____ IN. _____ FT.

RIG UP _____

SAND _____

DRILLING AND REMARKS:

GAS _____

OIL _____

TOTAL DEPTH 1488

PRODUCTION

1ST 24 HRS. NAT. _____

1ST 24 HRS. AFTER SHOT _____

GAS _____ CU. Ft.

DRY HOLE _____

ABANDONED ✓

DATE

Nov 29 1926 SCOUT