


DX 78-1 Ellis

Section 25 Township 13 Range 20W

Well No. #1 Orth

Company W. J. Coppinger

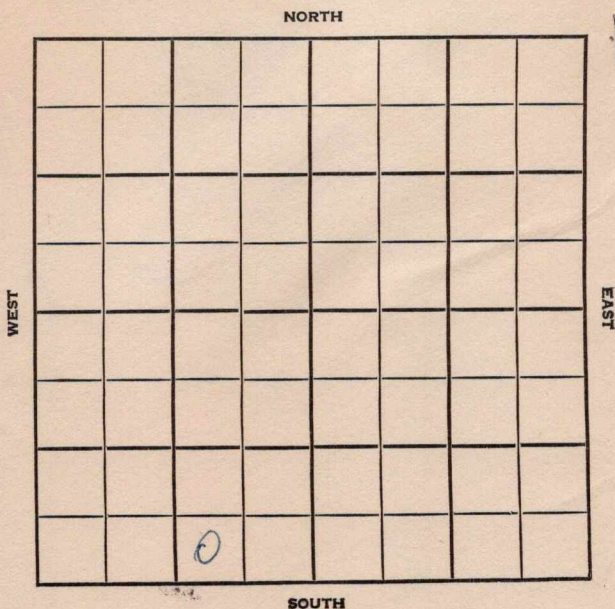

KANSAS

R.

20W

#1 Orth

FARM

COMPANY

W.J. Coppinger

CONTRACTOR

Co. Tools

N. Pleasant


FT. FROM N. LINE

FT. FROM S. LINE

FT. FROM E. LINE

FT. FROM W. LINE

SW SE SW

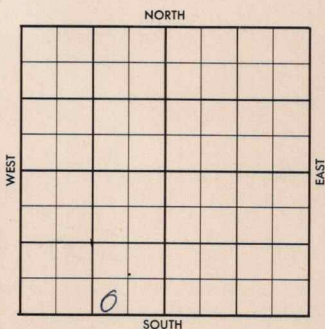

ELEVATION

1956

2211 RB, 2209 DF REPORT

8-15

Comm. 8-7-56
8" @ 212 w/125
drlg. 3120
Anh. 1507'

2211 RB

2209 DF

County Ellis

Elev.

Sec. 25

Twp.

13

Rge.

20WCompany W. J. Coppinger

FarmName

OrthNo. 1

TOPS

DEPTH

LOG

DATUM

Loc. in Sec.

Anh.

1507SW SE SW

Tp.

H.

Tr.

Dg.

BL.

L.

K.C.

B.K.C.

Ce.

C.

M.

M.

K.

Mz.

Me.

V.

S.

S.

A.

R.

Pe.

G.

T.D.

Geol.

Contr.

Co. tools

Pool

N. Pleasant

FIRST REPORT

0

Date Comm.

8-7-56

AUG 15 '56

8" @ 212/125 drlg. 3120

AUG 15 1956

D.R.

2211 RB

County EllisElev. 2209 DFSec. 25Twp. 13Rge. 20WCompany W. J. CoppingerFarm Name OrthNo. 1

TOPS	DEPTH	LOG	DATUM	Loc. in Sec.
Anh.	1507			SW SE SW
TP.				
H.	3458			
Tr.	3480			
Dg.				
Bl.				
L.	3502			Geol.
K.C.				Contr.
B.K.C.				Co. tools
Ce.				Pool
C.				N. Pleasant
M.				
M.				
K.				
Mz.				
Mq.				
V.				
S.				
S.				
A.	3841			
R.				
Pe.				
G.				
T.D.	3900			

Date Comm. 8-7-56

8" @ 212/125 drlg. 3120 AUG 22 '56

DST 3836-50 1hr rec 15' Md

BHP 20# crg @ 3882 AUG 29 '56

crg 3850-90 rec 40' 5 1/2 @

3894/100 co 14/3853-57 14/

3855-59 1 1/4" 10 Boph +

Lots wt. to sq SEP 5 '56 Dock sq

co 3880/3871-75 50d RPPF 24/

3853-59 B 2 1/2 Boph + 3 Bwph

POY SEP 12 '56 SEP 19 '56 SEP 26 '56

OCT 3 '56

Frac Pop

OCT 10 '56

OCT 17 '56

P. 16 Bopd + wtr.

OCT 24 '56

OCT 31 '56

OCT 7 '56

X WO Pot

NOV 13 '56

Pot.

tomorrow

NOV 21 '56

X Ph P. 145

Bopd + 53% wtr

Air P. 3853-59

graw 40°

25-13-20

sw sw sw