


Ellis

KANSAS

SECTION 25 TOWNSHIP 13 RANGE 20W

WELL NO. #1 Younger

COMPANY Lario

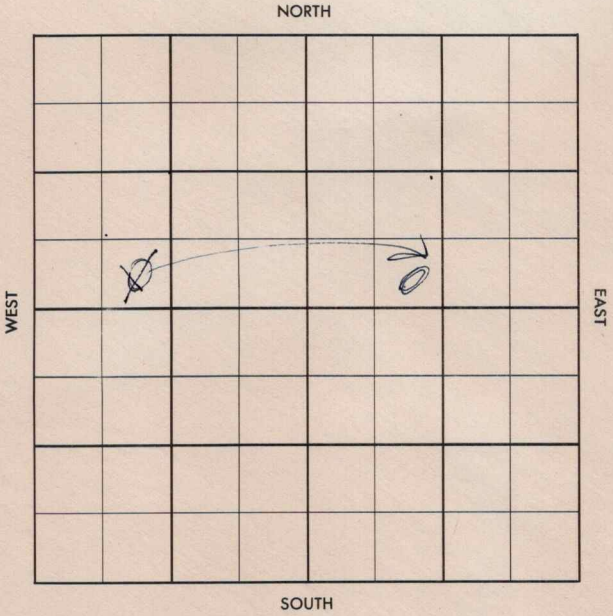

230202

FORM 513 SUNRAY

County Ellis Elev. _____
 Sec. 25 Twp. 13 Rge. 20W
 Company Lario
 Farm Name Younger No. 1

TOPS	DEPTH	LOG	DATUM	Loc. in Sec.
Anh.				SE SW NW
Tp.				
H.				
Tr.				
Dg.				
Bl.				
L.				Geol. _____
K.C.				Contr. _____
B.K.C.				Thunderbird
Ce.				Pool _____
C.				N. Pleasant
M.				
M.				
K.				
Mz.				
Me.				
V.				
S.				
S.				
A.				
R.				
Pe.				
G.				
T.D.				

FIRST REPORT

JAN 3 '57

Date Comm. _____
 Location _____

~~14~~

CORRECTION

FORM 513 SUNRAY

County Ellis Elev. 2143
 Sec. 25 Twp. 13 Rge. 20W
 Company Lario
 Farm Name Younger No. 1

TOPS	DEPTH	LOG	DATUM	Loc in Sec.
Anh.				SE SW NE
Tp.				
H.	3396			
Tr.	3422			
Dg.				
Bl.				
L.	3442			Charley King
K.C.				Geol.
B.K.C.				
Ce. <u>Marm</u>	3724			Contr.
C.	3738			Thunderbird
M.				
M.				Pool
K.				N. Pleasant
Mz.				
Mq.				
V.				
S.				
S.				
A <u>weath.</u>	3780			
R <u>solid Arb.</u>	3783			
Pf.				
G.				
T.D.	3791			COMPLETE

Date Comm. _____
 Location JAN 9 '57
1-4-57 850 235 / 135
2135 JAN 19 '57 DST 3517-32 1hr.
25' WM BHP 990/20 11 3680
JAN 23 '57 X DST 3741-55 op 1hr rec. 850' SW
BHP 500/20" DST 3784-91 op 1hr 230'
gas rec 2170' oil FP 500-650 BHP
775/20" 5 1/2 @ 3784 CO 3791 TP
FU 2000' oil in 3 hrs 20' W & 9

Bopk 4 hrs TE: RAIN 50 '57 FEB 6 '57

Ph P. 601 Bopd no/w
graw 39°

25-13-20W

se sw ne