Ellis KANSAS


SECTION 25 TOWNSHIP 13 RANGE 20W

WELL NO. #3 Younger

COMPANY Lario Oil & Gas

NORTH ~~NE SW SE~~ SW SW SE

15

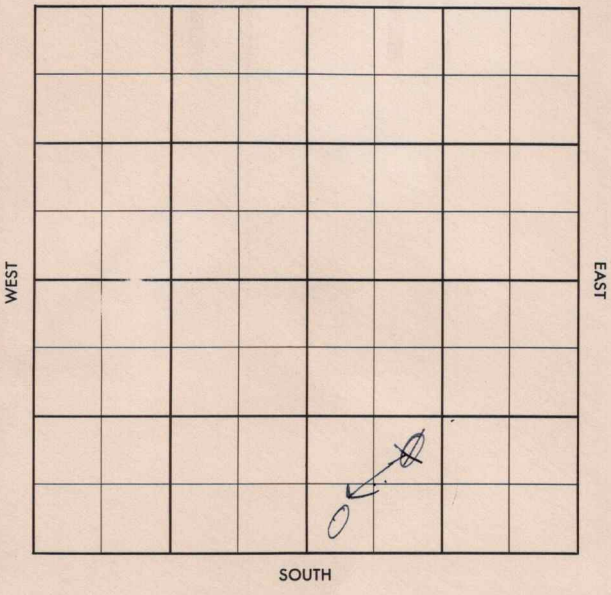

FORM 504-3 SUNRAY

FORM 513 SUNRAY

County Ellis Elev.

Sec. 25 Twp. 13 Rge. 20W

Company Lario Oil & Gas

Farm Name Younger No. 3

TOPS	DEPTH	LOG	DATUM
Anh.			
T.p.			
H.			
Tr.			
Dg.			
B.L.			
L.			
K.C.			
B.K.C.			
Ce.			
C.			
M.			
M.			
K.			
Mz.			
Mo.			
V.			
S.			
S.			
A			
R.			
P€.			
G.			
T.D.			

Loc. in Sec. NE SW SE

Geol.

Contr. Sterling Drl

Pool Pleasant No.

FIRST REPORT

MAR 27 '57

Date Comm.

Location

Co. Lse. No. Sec. T. R.

Pleasant Field CORRECTION

FORM 513 SUNRAY

County Ellis Elev. ~~2157~~ 2193 DF

Sec. 25 Twp. 13 Rge. 20W

Company Lario Oil & Gas

Farm Name Younger No. 3

TOPS	DEPTH	LOG	DATUM
Anh.			
T.P.			
H.		3438	
Tr.			
Dg.			
Bl.			
L.	3478	3478	
K.C.			
B.K.C.		3736	
Ce.			
C.			
M.			
M.			
K.			
Mz.			
Mc.			
V.			
S.			
S.			
A		3826	
R.			
P€.			
G.			
T.D.	3845		

Loc. in Sec.: ~~NE SW SE~~ SW SW SE

Geol.

Contr. Sterling Drl

Pool Pleasant No.

COMPLETE JUN 5 '57

Date Comm.

Location APR 5 '57 ✓ APR 10 '57 APR 17 '57 ✓

APR 24 '57 ✓ MAY 1 '57 4-29-57 8 5/8 240/150 WOC MAY 8 '57 ✓ Lsg 3478 ℗ 3502 MAY 15 '57 DST 3829-36 1hr 45' OCM BH press 0 DST 3835-42 1hr 35' SOCM BHP 0/20" DST 3837-45 1hr 15' Md No Show BHP 250/20" 5½ 3845 MAY 22 '57 CO 62/3828-40

FORM 513-1 SUNRAY

No show 1/2 ✓ 38 Gopk no
✓ 11.69 Bopk + Tr. wtr
lm Pcf MAY 29 '57 JUN 5 '57 X Ph P.
361 Bopd no lw est grav
37.5° Arb PF. 3826-40
RTD 3845

25-19-20W SW SW SE