


Kansas

Map No. _____ Sec. 14 Twp. 28 R. 6

Well No. 1 Lawson Farm _____

Lawson et al Company _____

NORTH

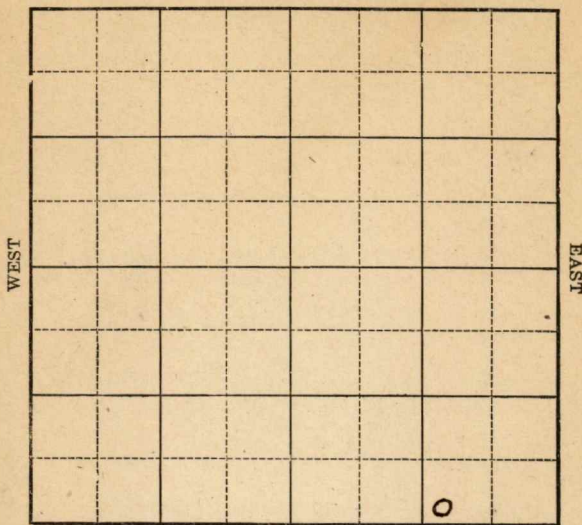

SOUTH

FIRST REPORT

Location _____

Drilling Remarks:

Rig Up _____

Drilling Remarks:

RECORD

Cased _____ in. _____ ft.

Sand _____

Gas _____

Oil _____

Total Depth _____

PRODUCTION

1st 24 hrs. Nat. _____

1st 24 hrs. after shot _____

Gas _____ cu. ft.

Dry Hole _____

Abandoned _____

Map No. _____ Sec. 14 Twp. 28 R. 6


Well No. 1 Farm _____
Lawson Et al Company _____

Ft. from N. Line

200 Ft. from S. Line

1120 Ft. from E. Line

Ft. from W. Line

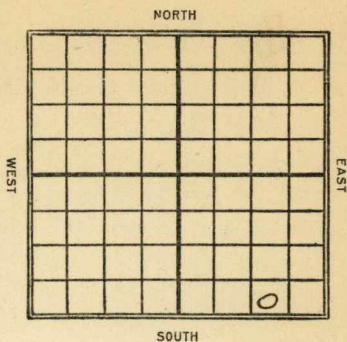

Date _____

REPORT

Date 1922

11/11 1923	Rig.
---------------	------

1923

3/22 D. + A. 2905

Map No. **KANSAS** 11 Sec. 14 Twp. 28 R. 6

Well No. 1

Lawson et al Company

Contractor

FIRST REPORT

SECTION PLAT

_____ Ft. from N. Line

200 Ft. from S. Line

1120 Ft. from E. Line

_____ Ft. from W. Line

Location *✓✓*

Rig up

Drilling and Remarks:

RECORD

Cased _____ in., _____ ft.

Sand _____

Gas _____

Oil _____

Total Depth _____

PRODUCTION

1st 24 hrs. Nat. _____

1st 24 hrs. after shot _____

Gas _____ Cu. Ft.

Dry Hole _____

Abandoned _____

Date

NOV 11 1922

M. A. BENEAR

191

Scout

Map No. **KANSAS** 11 Sec. 14 Twp. 28 R. 6

Well No. 1 Lawson

Lawson et al. Company

Contractor

ABANDONED


SECTION PLAT

_____ Ft. from N. Line

200 _____ Ft. from S. Line

1120 _____ Ft. from E. Line

_____ Ft. from W. Line

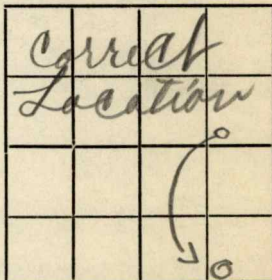

Location _____

Rig up _____

Drilling and Remarks:

2149
2905

RECORD

Cased _____ in., _____ ft.

Sand _____

Gas _____

Oil _____

Total Depth _____

PRODUCTION

1st 24 hrs. Nat. _____

1st 24 hrs. after shot _____

Gas _____ Cu. Ft.

Dry Hole _____

Abandoned _____

Date

M. A. BENEAR

MAR 22 1923

192

Scout