

*Butler*

Map No. **KANSAS** Sec. *35* Twp. *25<sup>S</sup>* R. *4<sup>E</sup>*

Well No. *1-1* *J. J. Steele* Farm  
*J. H. West* Company

NORTH

WEST

EAST

				<i>e</i>			
		<i>0</i>					

SOUTH

Location.....

Drilling Remarks

.....

.....

Rig Up.....

Drilling Remarks

.....

.....

**RECORD**

Cased..... in..... ft.

Sand.....

Gas.....

Oil.....

Total Depth.....

**PRODUCTION**

1st 24 hrs. Nat.....

1st 24 hrs. after shot.....

Gas..... cu. ft.....

Dry Hole.....

Abandoned.....

Map No. .... Sec. .... Twp. .... R. ....

Well No. .... Farm


..... Company

..... Ft. from N. Line

..... Ft. from S. Line

..... Ft. from E. Line

..... Ft. from W. Line

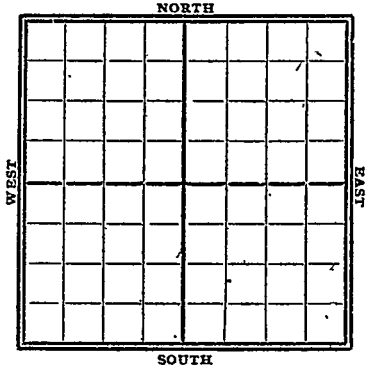

1917

Date

REPORT

*Gypsy Records*

4/18

*Abd T.D. 2490*

K14 MAP NO. KANSAS SEC. 35 TWP. 7SS R. 4E

WELL No. 1 J. Steele

J. H. Hart COMPANY

CONTRACTOR

ABANDONED

SECTION PLAT

2			

\_\_\_\_\_ FT. FROM N. LINE

\_\_\_\_\_ FT. FROM S. LINE

\_\_\_\_\_ FT. FROM E. LINE

\_\_\_\_\_ FT. FROM W. LINE

RECORD

LOCATION \_\_\_\_\_

CASED \_\_\_\_\_ IN. \_\_\_\_\_ FT.

RIG UP \_\_\_\_\_

SAND \_\_\_\_\_

DRILLING AND REMARKS:

GAS \_\_\_\_\_

OIL \_\_\_\_\_

TOTAL DEPTH 2440

PRODUCTION

1ST 24 HRS. NAT. \_\_\_\_\_

1ST 24 HRS. AFTER SHOT \_\_\_\_\_

GAS \_\_\_\_\_ CU. FT.

DRY HOLE

ABANDONED

DATE

4-18 1927

SCOUT