

Section 15 Township 28 Range 6 E

Well No. 1 Pettit

Company Cromwell & Lewis

Wildcat

NORTH

WEST

EAST

	0						

SOUTH

KANSAS

Butler

Sec. 15 Twp. 28 R. 6E

Well No. #1 Pettit Farm

Cromwell & Lewis Company

Wildcat


330' Ft. from N. Line

 Ft. from S. Line

 Ft. from E. Line

990' Ft. from W. Line

NE NW SW

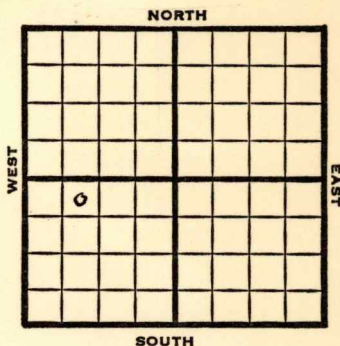

1949	Elev.	REPORT
5/11		Location
5/18	"	
5/25	15" @ 125'	
	Drlg. 575'	
6/1	Drlg. 1250'	
6/7	13"@ 841'	
	10"@ 1500'	
	KC 2080'	
	Drlg 2225'	
6/15	Miss 2738'	
	Drlg. 2905'	
6/22	Arb 3121'	
	TD 3142'	
	ABANDONED	

Map No. _____ Sec. 15 Twp. 28 R. 6E

Well No. 1 Pettit

Cromwell & Lewis

Company

H & M Drlg.

Contractor

NE NW SW

FIRST REPORT
SECTION PLAT

330


Ft. from N. Line

Ft. from S. Line

Ft. from E. Line

990

Ft. from W. Line

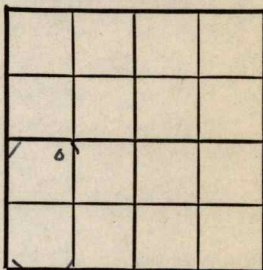

Butler County

Location X

Rig up _____

Drilling and Remarks:

RECORD

Cased _____ in., _____ ft.

Sand _____

Gas _____

Oil _____

Total Depth _____

PRODUCTION

1st 24 hrs. Nat. _____

1st 24 hrs. after shot _____

Gas _____ Cu. Ft.

Dry Hole _____

Abandoned _____

Date

MAY 11 1949 19

S. J. LEWIS

Scout

Kansas

Wildcat

Map No. K11 Sec. 15 Twp. 28 R. 6EWell No. 1 PettitCromwell & Lewis


Company

ABANDONED

Contractor

NE NW SW

SECTION PLAT

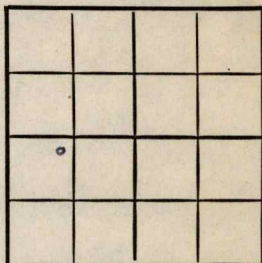330 Ft. from N. Line Ft. from S. Line Ft. from E. Line990 Ft. from W. LineButler County

RECORD

Location Rig up

Drilling and Remarks:

Cased in., ft.Sand Gas Oil Total Depth 3142

PRODUCTION

1st 24 hrs. Nat. 1st 24 hrs. after shot Gas Cu. Ft.Dry Hole Abandoned

Date

JUN 22 1949 19S. J. LEWIS

Scout