

Map No. KANSAS Sec. B3 Twp. 25^S 4^E R.

Well No. 1- Gray Farm
Towanda O & G Company

NORTH

WEST

EAST

				0			

SOUTH

Location.....

Drilling Remarks.....

.....

.....

Rig Up.....

Drilling Remarks.....

.....

.....

RECORD

Cased..... in..... ft.

Sand.....

Gas.....

Oil.....

Total Depth.....

PRODUCTION

1st 24 hrs. Nat.....

1st 24 hrs. after shot.....

Gas..... cu. ft.....

Dry Hole.....

Abandoned.....

Map No. Sec. Twp. R.

Well No. Farm


..... Company

..... Ft. from N. Line

..... Ft. from S. Line

..... Ft. from E. Line

..... Ft. from W. Line

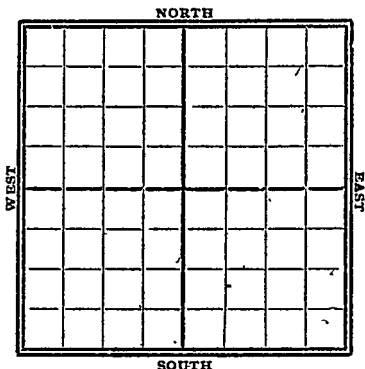

1917

Date

REPORT

Gypsy Records

12/19

Abd T.O. 3310'

K 14 KANSAS SEC. 33 TWP. 455 R. 4E

WELL NO. 1
Jowanda Oil Co. COMPANY

CONTRACTOR

SECTION PLAT

ABANDONED

_____ FT. FROM N. LINE
_____ FT. FROM S. LINE
_____ FT. FROM E. LINE
_____ FT. FROM W. LINE

		0	

LOCATION _____
RIG UP _____
DRILLING AND REMARKS:

RECORD

CASED _____ IN. _____ FT.
SAND _____
GAS _____
OIL _____
TOTAL DEPTH 3310

PRODUCTION

1ST 24 HRS. NAT. _____
1ST 24 HRS. AFTER SHOT _____
GAS _____ Cu. Ft.
DRY HOLE ✓
ABANDONED ✓

DATE 12-19-17

SCOUT