


Map No. KANSAS Sec. 17 Twp. 35 R. 2E

Well No. 1-Bowman Farm
Chas Balph Company

NORTH

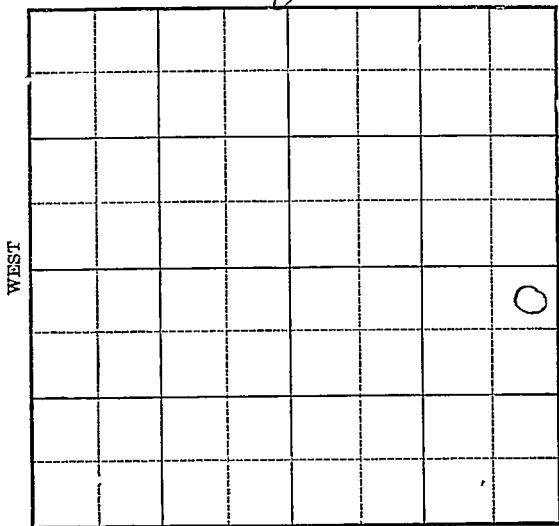

Location _____

Drilling Remarks _____

RECORD

Cased _____ in. _____ ft.

Sand _____

Gas _____

Oil _____

Total Depth _____

Rig Up _____

Drilling Remarks _____

PRODUCTION

1st 24 hrs. Nat. _____

1st 24 hrs. after shot _____

Gas _____ cu. ft.

Dry Hole _____

Abandoned _____

Map No. KANSAS Sec. 17 Twp. 35 R. 2E


Well No. 1-Bowman Farm
Chas Balph Company

330 Ft. from N. Line

_____ Ft. from S. Line

330 Ft. from E. Line

_____ Ft. from W. Line

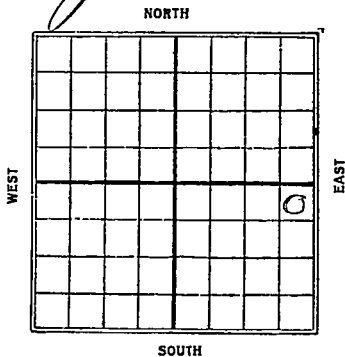

1927

Date

REPORT

12/28 Pond

1928

1/4 cellar

1/10 _____

1/18 _____

1/25 cellar S. & A.

Map No. KANSAS Sec. 17 Twp. 35 R. 2E

Well No. 1 Bowman

Chas. Balph Company

Contractor

SECTION PLAT

			0

330 Ft. from N. Line

_____ Ft. from S. Line

330 Ft. from E. Line

_____ Ft. from W. Line

FIRST REPORTS

Location _____

Rig up _____

Drilling and Remarks:

Pond

RECORD

Cased _____ in., _____ ft.

Sand _____

Gas _____

Oil _____

Total Depth _____

PRODUCTION

1st 24 hrs. Nat. _____

1st 24 hrs. after shot _____

Gas _____ Cu. Ft.

Dry Hole _____

Abandoned _____

Date

DEC 28 1927

S. J. LEWIS

Map No. **KANSAS** Sec. 17 Twp. 05 R. 2E

Well No. 1 Bowman

Chas Balph Company

Contractor

SECTION PLAT

320 Ft. from N. Line

_____ Ft. from S. Line

320 Ft. from E. Line

_____ Ft. from W. Line

			0

ABANDONED

Location _____

Rig up _____

Drilling and Remarks:

Cellar
I & A

RECORD

Cased _____ in., _____ ft.

Sand _____

Gas _____

Oil _____

Total Depth _____

PRODUCTION

1st 24 hrs. Nat. _____

1st 24 hrs. after shot _____

Gas _____ Cu. Ft.

Dry Hole _____

Abandoned _____

Date.

JAN 25 1928
192

S. J. LEWIS Scout