

FORM 51 5M 10-41 PETROL

Section 23 Township 17 Range 11-W

Well No. #1-C ~~12~~ Staatz ~~511~~

Company Bartlett & Crum

NORTH Krait Prusa Pool

WEST

EAST

SOUTH

0

Sec. 23 Twp. 17 R. 11-W

Well No. #1 ~~11~~ Staatz ~~13~~ "C" Farm

Bartlett & Crum

Company

(Kraft Prusa)


 Ft. from N. Line

990 Ft. from S. Line

 Ft. from E. Line

330 Ft. from W. Line

Elev. 1840

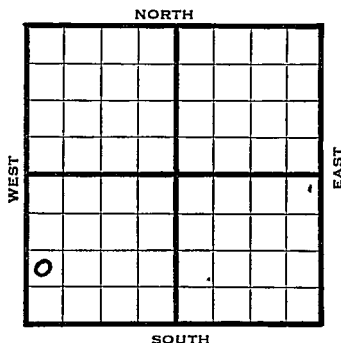

1942

REPORT

7/8 SD 100'
7/15 "
7/22 "
7/29 "
8/5 "
8/12 "
8/19 "
8/27 "
9/2 "
9/9 "
9/16 "
9/23 "
9/30 "
10/7 "
10/14 T.D. 100'

ABANDONED

Barton

KANSAS

Map No. 55 Sec. 23 Twp. 17 R. 11WWell No. 2 Staatz "B"Bartlett & Crum Company~~FIRST REPORT~~ Contractor

NW SW SW

SECTION PLAT

0			

 Ft. from N. Line990 Ft. from S. Line Ft. from E. Line330 Ft. from W. LineKRAFT PRUSA POOLLocation Rig up

Drilling and Remarks:

100' Shut Down

RECORD

Cased in., ft.Sand Gas Oil Total Depth

PRODUCTION

1st 24 hrs. Nat. 1st 24 hrs. after shot Gas Cu. Ft.Dry Hole Abandoned

Date

JUL 8 1942 19S. J. LEWIS Scout

KANSAS

Barton

Map No. 55 Sec. 23 Twp. 17 R. 11WWell No. 1 Staatz "C"Bartlett & Crum


Company

CORRECTION

Contractor

NW SW SW

SECTION PLAT

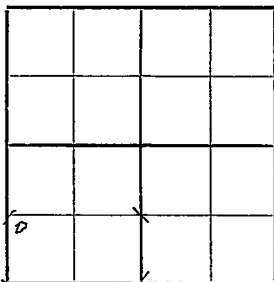 Ft. from N. Line990 Ft. from S. Line Ft. from E. Line330 Ft. from W. LineKRAFT PRUSA POOLLocation Rig up

Drilling and Remarks:

Reported

#2 Staatz "B"

RECORD

Cased in., ft.Sand Gas Oil Total Depth

PRODUCTION

1st 24 hrs. Nat. 1st 24 hrs. after shot Gas Cu. Ft.Dry Hole Abandoned

Date

JUL 29 1942

19

S. J. LEWIS Scout

Barton

KANSAS

Map No. 55 Sec. 23 Twp. 17 R. 11WWell No. 1 Staatz "C"Bartlett & Crum CompanyABANDONED Contractor

NW SW SW

SECTION PLAT

0			

 Ft. from N. Line990 Ft. from S. Line Ft. from E. Line330 Ft. from W. Line

KRAFT PRUSA POOL

Location Rig up

Drilling and Remarks:

RECORD

Cased in., ft.Sand Gas Oil Total Depth 100'

PRODUCTION

1st 24 hrs. Nat. 1st 24 hrs. after shot Gas Cu. Ft.Dry Hole Abandoned

Date

OCT 14 1942

19

S. J. LEWIS Scout