


Butler

KANSAS

Section 16 Township 28 Range 6E

Well No. #2 Cotton

Company Ben Gralapp et al

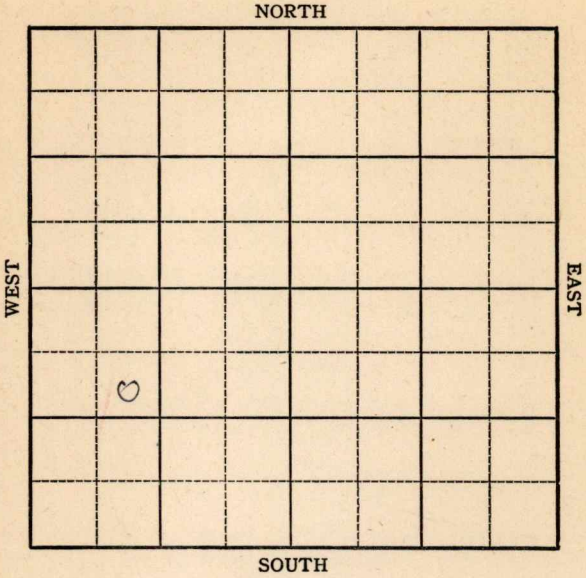

KANSAS

Butler ✓

Sec. 16 Twp. 28 R. 6-E

Well No. #2 Cotton Farm

Ben Gralapp et al Company

Watson Drlg Contractor  
Pettit Pool


990 Ft. from N. Line

Ft. from S. Line

Ft. from E. Line

990 Ft. from W. Line

SE NW SW

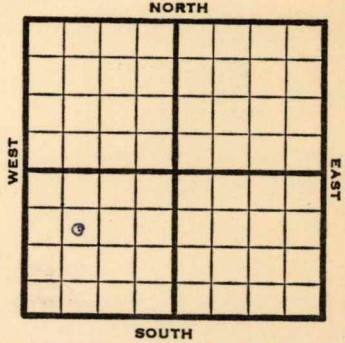

1950

REPORT

2/1

Location

4/19

TD 3153'

Bart 2650'

Miss 2765'

Simp 3128'

Arb. 3144'

D&A

Aband.

**ABANDONED**

Kansas

Map No. \_\_\_\_\_ Sec. 16 Twp. 28 R. 6E

Well No. 2 Cotton

Ben Gralapp etal. Company

Watson Drlg. Contractor

SE NW SW

SECTION PLAT

990 Ft. from N. Line

\_\_\_\_\_ Ft. from S. Line

\_\_\_\_\_ Ft. from E. Line

990 Ft. from W. Line


FIRST REPORT

Butler County

Location X

Rig up \_\_\_\_\_

Drilling and Remarks:

RECORD

Cased \_\_\_\_\_ in., \_\_\_\_\_ ft.

Sand \_\_\_\_\_

Gas \_\_\_\_\_

Oil \_\_\_\_\_

Total Depth \_\_\_\_\_

PRODUCTION

1st 24 hrs. Nat. \_\_\_\_\_

1st 24 hrs. after shot \_\_\_\_\_

Gas \_\_\_\_\_ Cu. Ft.

Dry Hole \_\_\_\_\_

Abandoned \_\_\_\_\_

Date

FEB 1 1950

J. E. TYRA Scout

Kansas

Map No. \_\_\_\_\_ Sec. 16 Twp. 28 R. 6E

Well No. 2 Cotton

Ben Gralapp et al. Company

Contractor

SE NW SW

E. 1387  
SECTION PLAT

990 Ft. from N. Line

\_\_\_\_\_ Ft. from S. Line

\_\_\_\_\_ Ft. from E. Line

990 Ft. from W. Line



Butler County

Location \_\_\_\_\_

Rig up \_\_\_\_\_

Drilling and Remarks:

Barb. 2650  
Miss. 2765  
Simp. 3128  
arb. 3144

D+A

RECORD

Cased \_\_\_\_\_ in., \_\_\_\_\_ ft.

Sand \_\_\_\_\_

Gas \_\_\_\_\_

Oil \_\_\_\_\_

Total Depth 3153

PRODUCTION

1st 24 hrs. Nat. \_\_\_\_\_

1st 24 hrs. after shot \_\_\_\_\_

Gas \_\_\_\_\_ Cu. Ft.

Dry Hole \_\_\_\_\_

Abandoned \_\_\_\_\_

Date

APR 19 1950

J. E. TYRA Scout