

Butler Co

Map No. Kansas Sec. 17 Twp. 28 R. 6

Well No. 1 Pettit Farm


Phillips Pet Company

..... Ft. from N. Line

330 Ft. from S. Line

330 Ft. from E. Line

..... Ft. from W. Line

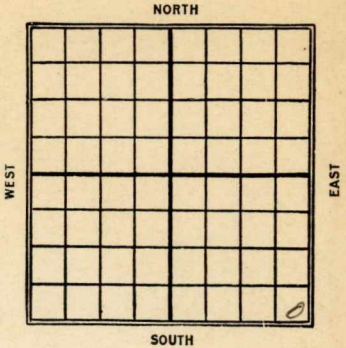

Date	REPORT
1926	
4/14	Location
4/21	Rig
4/30	Rign
5/8	Dly 300'
5/12	" 1100
5/19	" 1720
6/2	" 2250
6/10	" 2450
6/18	" 2800
6/25	" 3020
6-30	Tap line 2800' Lab by 3045-3132' sand 3132-3136' 900' of in lab
7/8	T.D. 3142' swabbed 20 bbls, 5.0
7/15	---
7/22	---
7/28	---
8/4	---
8/11	---
8/18	same
8/25	Wil 3132-3143, top line 2800 20 bbls natural - 5.0 3143

Butler

K 11 KANSAS Sec. *17* Twp. *28* R. *6*

Well No. *1*

Phillips Petroleum Co Company

Contractor

FIRST REPORTS

SECTION PLAT

----- Ft. from N. Line

330

----- Ft. from S. Line

330

----- Ft. from E. Line

----- Ft. from W. Line

Location -----

Rig up -----

Drilling and Remarks:

RECORD

Cased ----- in., ----- ft.

Sand -----

Gas -----

Oil -----

Total Depth -----

PRODUCTION

1st 24 hrs. Nat. -----

1st 24 hrs. after shot -----

Gas ----- Cu. Ft.

Dry Hole -----

Abandoned -----

Date

APR 14 1926

192

CHAS. L. SHERWOOD

Scout

Butler

11 KANSAS

Map No. _____ Sec. ¹⁷ Twp. ²⁸ R. ⁶

Well No. ¹ _____

Phillip Det Co

Company

Contractor

COMPLETED

SECTION PLAT

_____ Ft. from N. Line

330

_____ Ft. from S. Line

330

_____ Ft. from E. Line

_____ Ft. from W. Line

			0

Location _____

Alex

Rig up _____

Drilling and Remarks:

Top line 2800

20 lbs natural

RECORD

Cased _____ in. _____ ft.

Sand 3132-3143

Gas _____

Oil _____

Total Depth 3143

PRODUCTION

1st 24 hrs. Nat. _____

1st 24 hrs. after shot _____

Gas _____ Cu. Ft.

Dry Hole _____

Abandoned _____

Date

AUG 25 1926

CHAS. L. SHERWOOD

192

Scout