


Section 27 Township 13 Range 14W

Well No. #1 Boxberger "E"

Company B & R Drlg.

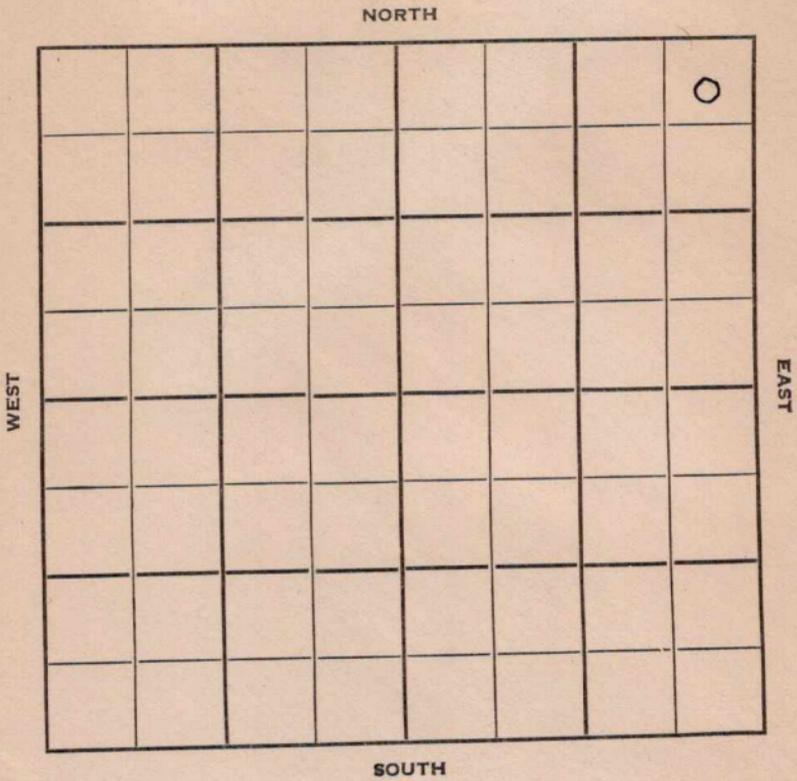

Russell

KANSAS

Sec. 27 Twp. 13 R. 14W

Well No. #1 Boxberger "E" Farm

B & R Drlg. Company

Russell Pool Contractor


330' Ft. from N. Line

_____ Ft. from S. Line

330' Ft. from E. Line

_____ Ft. from W. Line

NE NE NE

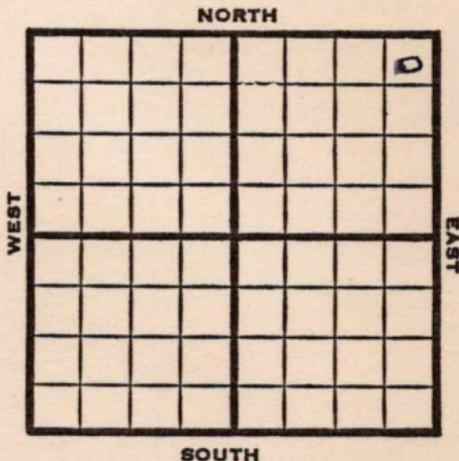

1951 Elev. 1837' REPORT

8/22 Spud 8-15-51
8" @ 178
Anhy 865-85
Drlg. 2175'

10/24 Spud 8-15-51
Oil Well TD 3258
8" @ 178
Anhy 865-85 Heeb. 2921
Lans. 2979 Arb. 3254-57
5" @ 3254 TD 3258
Comp. 50 BOPD

COMPLETED

County Russell State Kansas

Sec. 27 (Blk. 13 (Sur. 14W (Twp. 13 (Rge. 14W Map No.

Operator B & R Drlg.

Well No. 1 Farm Boxberger "E"

Elev. 1837 Location NE NE NE

COMPLETE

330 Ft. From N Line NE

330 Ft. From E Line Quarter

Ist. Report

Completion OCT 24 1951

Remarks Russell Pool


Spudding Date 8-15-51

Drlg. Data Oil well TD 3258

8" @ 178 Anhy 865-85 Heeb. 2921

Lans. 2979 Arb. 3254-57 5" @ 3254

TD 3258 Comp. 50 bopd

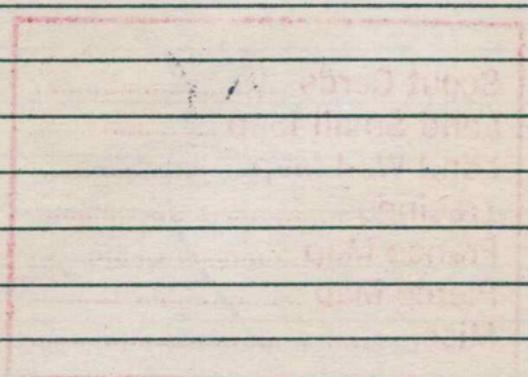

J. E. TYRA