


Section 17 Township 28 Range 6-E

Well No. 1 Wandell

Company Cromwell & Lewis

NORTH Miscellaneous

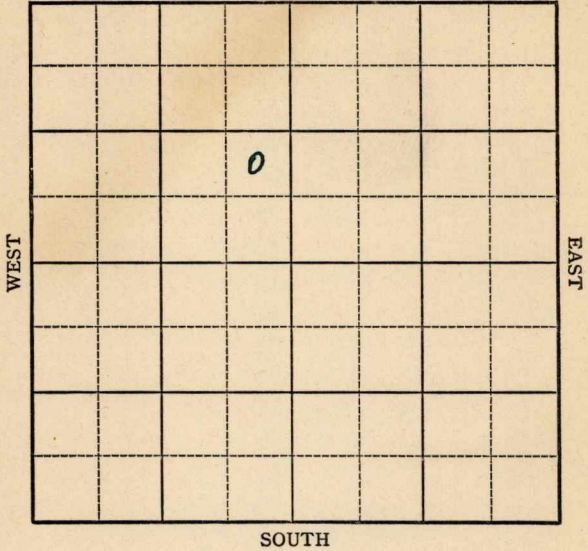

KANSAS

Butler

Sec 17 Twp. 28 R. 6-E

Well No. #1 Wandell Farm

Cromwell & Lewis Company

(Misc.)


 Ft. from N. Line

990 Ft. from S. Line

330 Ft. from E. Line

 Ft. from W. Line

Elev. 1379

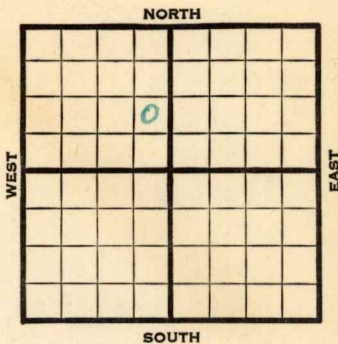

1942	REPORT
1/21	Location
1/29	Cable rig.
2/5	Spud 10'
2/12	SD 10'
2/19	Drlg. 740'
2/26	12" - 940' Drlg. 1315'
3/5	S.D. 1875'
3/12	10" - 1875' C.O.
3/19	K.C. 2108' 8" - 2280' Drlg. 2475'
3/26	SD 2480'
4/2	6" - 2475' Miss. 2793' B. Miss. 3038' Drlg. 3062'
4/8	Simp. 3132' T.D. 3144' H.F.W.
	ABANDONED

KANSAS

Butler

Map No. 11 Sec. 17 Twp. 28 R. 6E

Well No. 1 Wandell

Cromwell & Lewis Company

ABANDONED

Contractor

NE SE NW

SECTION PLAT

		o	

_____ Ft. from N. Line

990 Ft. from S. Line

330 Ft. from E. Line

_____ Ft. from W. Line

MISCELLANEOUS

Location _____

Rig up _____

Drilling and Remarks:

Sum 3132

AFW

RECORD

Cased _____ in., _____ ft.

Sand _____

Gas _____

Oil _____

Total Depth 3144

PRODUCTION

1st 24 hrs. Nat. _____

1st 24 hrs. after shot _____

Gas _____ Cu. Ft.

Dry Hole _____

Abandoned _____

Date

APR 8 1942 19

S. J. LEWIS Scout

Map No. 11 Sec. 17 Twp. 28 R. 6E

Well No. 1 Wandell

Cromwell & Lewis Company

FIRST REPORT Contractor

NE SE NW

SECTION PLAT

		o	

_____ Ft. from N. Line

990 Ft. from S. Line

330 Ft. from E. Line

_____ Ft. from W. Line

MISCELLANEOUS

Location XX

Rig up _____

Drilling and Remarks:

~ 7

RECORD

Cased _____ in., _____ ft.

Sand _____

Gas _____

Oil _____

Total Depth _____

PRODUCTION

1st 24 hrs. Nat. _____

1st 24 hrs. after shot _____

Gas _____ Cu. Ft.

Dry Hole _____

Abandoned _____

Date

JAN 21 1942 19

S. J. LEWIS Scout