


KANSAS

Map No. \_\_\_\_\_ Sec. 23 Twp. 26 R. 14E

Well No. 12-Lumber Farm \_\_\_\_\_

Peerless O. & K. Company

NORTH

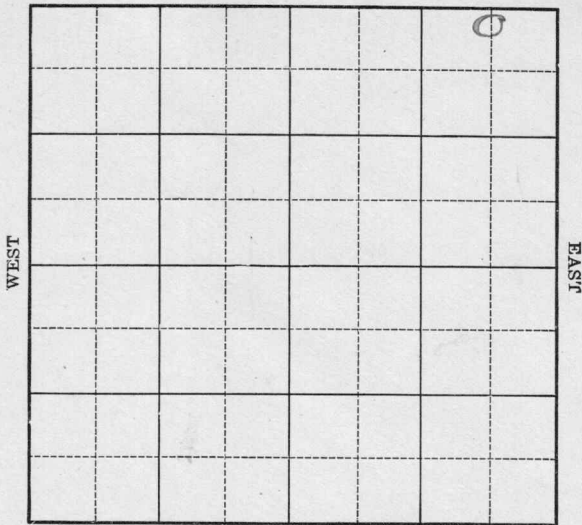

SOUTH

Location \_\_\_\_\_

Drilling Remarks \_\_\_\_\_

\_\_\_\_\_

\_\_\_\_\_

Rig Up \_\_\_\_\_

Drilling Remarks \_\_\_\_\_

\_\_\_\_\_

\_\_\_\_\_

RECORD

Cased \_\_\_\_\_ in. \_\_\_\_\_ ft.

Sand \_\_\_\_\_

Gas \_\_\_\_\_

Oil \_\_\_\_\_

Total Depth \_\_\_\_\_

PRODUCTION

1st 24 hrs. Nat. \_\_\_\_\_

1st 24 hrs. after shot \_\_\_\_\_

Gas \_\_\_\_\_ cu. ft.

Dry Hole \_\_\_\_\_

Abandoned \_\_\_\_\_

Map No. KANSAS Sec. 23 Twp. 26 R. 14


Well No. 12 - Lauber Farm  
Peerless O. & R. Company

200 Ft. from N. Line

\_\_\_\_\_ Ft. from S. Line

660 Ft. from E. Line

\_\_\_\_\_ Ft. from W. Line

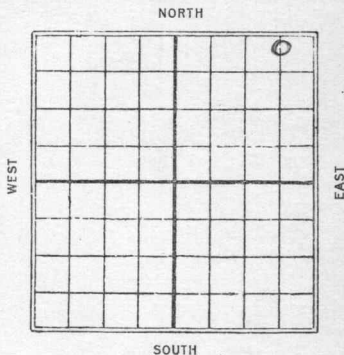

1928

Date

REPORT

Date	REPORT
<u>4/19</u>	<u>Spudding</u>
<u>4/26</u>	<u>—</u>
<u>5/3</u>	<u>—</u>
<u>5/10</u>	<u>—</u>
<u>5/18</u>	<u>Drly 1200</u>
<u>5/24</u>	<u>—</u>
<u>5/31</u>	<u>—</u>
<u>6/7</u>	<u>S.D. 1200</u>
<u>6/14</u>	<u>—</u>
<u>6/21</u>	<u>—</u>
<u>6/28</u>	<u>—</u>
<u>7/6</u>	<u>—</u>
<u>7/13</u>	<u>—</u>
<u>7/19</u>	<u>—</u>
<u>7/25</u>	<u>No sand - R. &amp; D. 1305'</u>

Woodson

KANSAS

Map No. \_\_\_\_\_ Sec. 23 Twp. 26 R. 14 E

Well No. 12 Rancher

Peerless Oil Co Company

Contractor

FIRST REPORTS

SECTION PLAT

700 Ft. from N. Line

\_\_\_\_\_ Ft. from S. Line

660 Ft. from E. Line

\_\_\_\_\_ Ft. from W. Line

			o

Location \_\_\_\_\_

Rig up \_\_\_\_\_

Drilling and Remarks:

Aply

RECORD

Cased \_\_\_\_\_ in., \_\_\_\_\_ ft.

Sand \_\_\_\_\_

Gas \_\_\_\_\_

Oil \_\_\_\_\_

Total Depth \_\_\_\_\_

PRODUCTION

1st 24 hrs. Nat. \_\_\_\_\_

1st 24 hrs. after shot \_\_\_\_\_

Gas \_\_\_\_\_ Cu. Ft.

Dry Hole \_\_\_\_\_

Abandoned \_\_\_\_\_

Date

APR 19 1928

192

CHAS. L. SHERWOOD

Scout

Woodson

no mining  
KANSAS SEC. 23 TWP. 26 R. 14

WELL No. 12 hauber

fearless RR Co COMPANY

CONTRACTOR

COMPLETED

SECTION PLAT

			0

200 FT. FROM N. LINE

FT. FROM S. LINE

660 FT. FROM E. LINE

FT. FROM W. LINE

ABANDONED

LOCATION

RIG UP

DRILLING AND REMARKS:

No Sand

Depth 1305

RECORD

CASED \_\_\_\_\_ IN. \_\_\_\_\_ FT.

SAND \_\_\_\_\_

GAS \_\_\_\_\_

OIL \_\_\_\_\_

TOTAL DEPTH 1305

PRODUCTION

1ST 24 HRS. NAT. \_\_\_\_\_

1ST 24 HRS. AFTER SHOT \_\_\_\_\_

GAS \_\_\_\_\_ CU. FT.

DRY HOLE ✓

ABANDONED ✓

DATE

JUL 25 1928

CHAS. L. SHERWOOD

192

SCOUT