


KANSAS

Rice county

Section 2 Township 18 Range 8-W

Well No. #1, Goodwin

Company Nelson Drilling Company

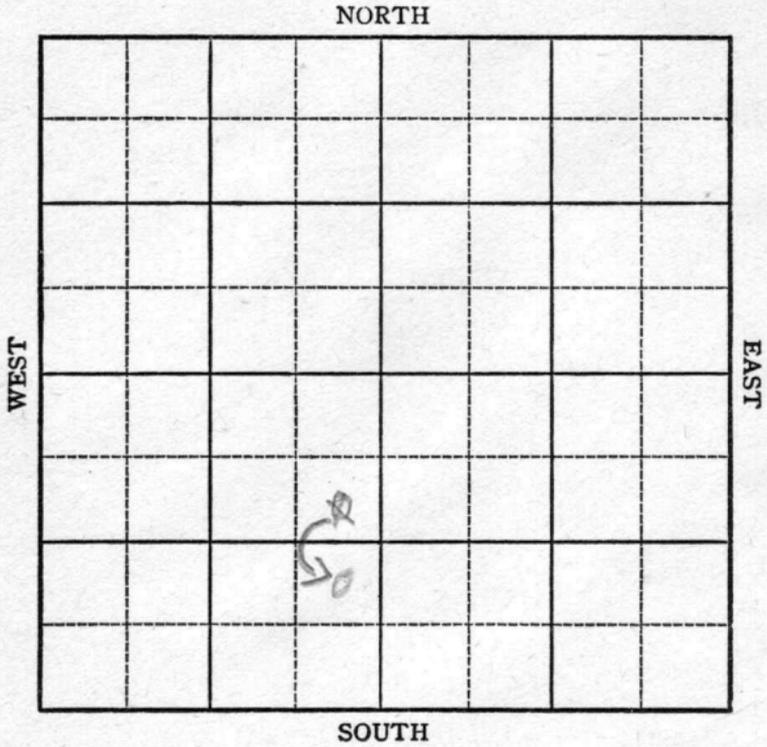

Sec. 2 Twp. 18 R. 8-W

Well No. #1, Goodwin Farm

Nelson Drilling Company Company

Geneseo Pool


~~990'~~ Ft. from N. Line

990 Ft. from S. Line

330' Ft. from E. Line

_____ Ft. from W. Line

~~NE SE SW~~
~~SE NE SW~~

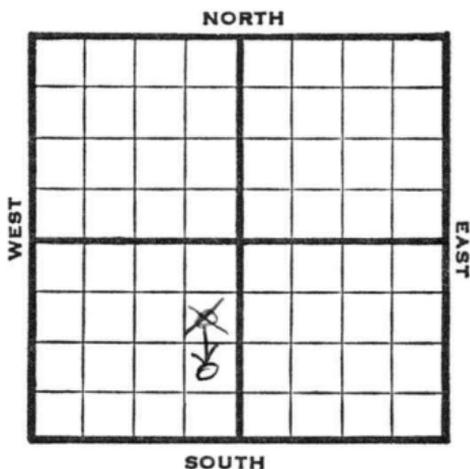

1946

Elev. 1772

REPORT

12/18

8" @ 190'

WOC

1947

1/4

Arb 3297

3261 TD

5" @ 3261 RUST

1/8

"

"

1/15

Lans 2844

Simp 3239

TD 3303'

H P W

Squeeze

1/21

44 shots 2847-70-500

Acid 20 gals W to 8 gals oil

PH 3000 acid 2 W gas

1/29

TD 3302'

Simp. 3239

Arb 3297

5" @ 3299

Perf Simp.

1 M Gas

COMPLETED

Map No. _____ Sec. 2 Twp. 18 R. 8W

Well No. 1 Goodwin

Nelson Drlg. Company

FIRST REPORT Contractor

SE NE SW


SECTION PLAT

990 Ft. from N. Line

_____ Ft. from S. Line

330 Ft. from E. Line

_____ Ft. from W. Line

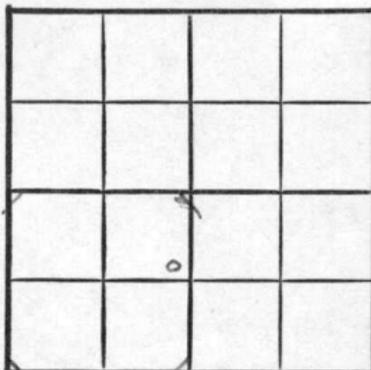

Rice County

Location _____

Rig up _____

Drilling and Remarks:

8" @ 190 WOC

RECORD

Cased _____ in., _____ ft.

Sand _____

Gas _____

Oil _____

Total Depth _____

PRODUCTION

1st 24 hrs. Nat. _____

1st 24 hrs. after shot _____

Gas _____ Cu. Ft.

Dry Hole _____

Abandoned _____

Date

DEC 1 8 1946

19

S. J. LEWIS

Scout

45

Kansas

KANSAS Geneseo Pool

Map No. 45 Sec. 2 Twp. 18 R. 8W


Well No. 1 Goodwin

Nelson Drlg. Company

CORRECTION Contractor

NE SE SW

SECTION PLAT

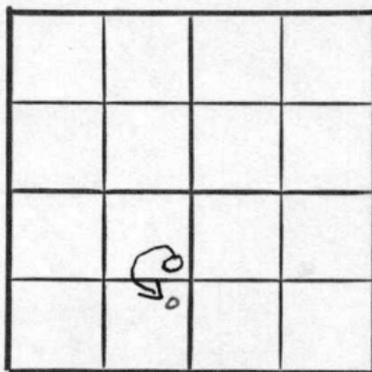

_____ Ft. from N. Line

990 Ft. from S. Line

330 Ft. from E. Line

_____ Ft. from W. Line

Rice County

Location _____

Rig up _____

Drilling and Remarks:

Reported

SE NE SW

RECORD

Cased _____ in., _____ ft.

Sand _____

Gas _____

Oil _____

Total Depth _____

PRODUCTION

1st 24 hrs. Nat. _____

1st 24 hrs. after shot _____

Gas _____ Cu. Ft.

Dry Hole _____

Abandoned _____

Date

JAN 2 1947 19

S. J. LEWIS Scout

Map No. 45 Sec. 2 Twp. 18 R. 8W

Well No. 1 Goodwin


Nelson Drlg. Company

COMPLETE Contractor

NE SE SW

E1, 1972

SECTION PLAT

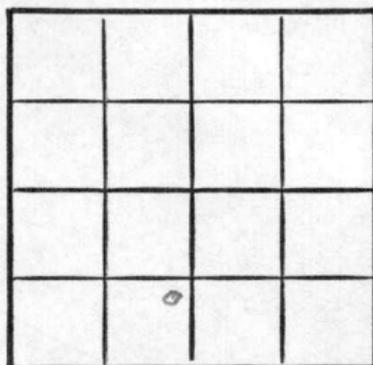

_____ Ft. from N. Line

990 Ft. from S. Line

330 Ft. from E. Line

_____ Ft. from W. Line

Rice County

Location _____

Rig up _____

Drilling and Remarks:

Impress 2289
Ray 3297
5' @ 3299
Prof. Sunjv
1 M Gas.

RECORD

Cased _____ in., _____ ft.

Sand _____

Gas _____

Oil _____

Total Depth 3302

PRODUCTION

1st 24 hrs. Nat. _____

1st 24 hrs. after shot _____

Gas _____ Cu. Ft.

Dry Hole _____

Abandoned _____

Date

JAN 29 1947

19

S. J. LEWIS

Scout