


Section 27 Township 13 Range 14W

Well No. #1 Butler

Company Shields Oil Prod.

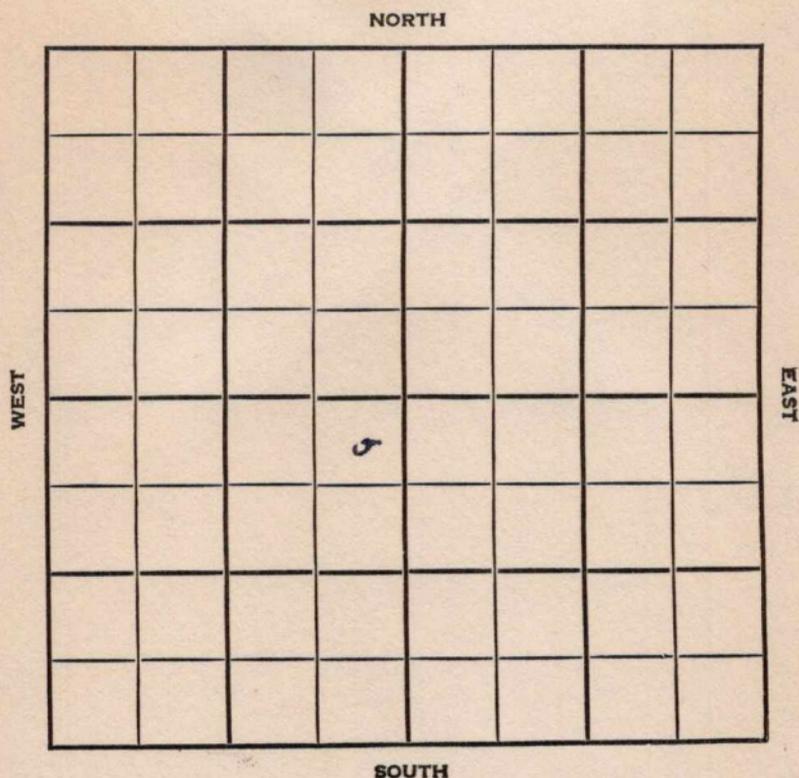

Russell

KANSAS

SEC. 27	TWP. 13	R. 14 W
------------	------------	------------

WELL NO. # 1 Butler FARM

COMPANY Shields Oil Prod.

CONTRACTOR


Townsite

\_\_\_\_\_ Ft. from N. Line

\_\_\_\_\_ Ft. from S. Line

\_\_\_\_\_ Ft. from E. Line

\_\_\_\_\_ Ft. from W. Line

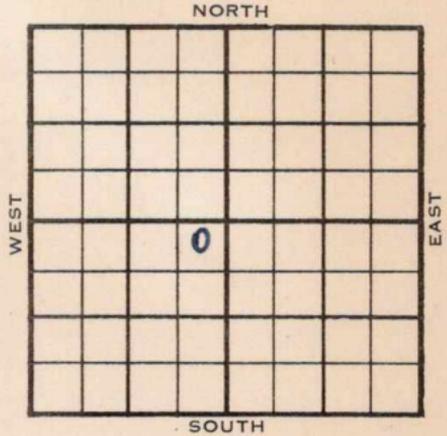

NE NE SW

1955	ELEVATION 1840'	REPORT
------	--------------------	--------

6/15

Comm. 5-5-55  
 8" @ 889/100 5" @ 3265/75  
 CO to TD B/1/2 BOPH 4 hr. 500 A  
 S/24 BO 3 hr.  
 Comp. 25 BOPD  
 Anh. 865', H. 2936', Tr. 2956'  
 L. 2995' A. 3264'  
 TD 3276'

**FIRST REPORT  
 COMPLETED**

County Russell Elev. 1840

Sec. 27 Twp. 13 Rge. 14W

Company Shields Oil Prod.

Farm Name Butler No. 1

TOPS	DEPTH	LOG	DATUM	Loc. in Sec.
Anh.	<u>865</u>			NE NE SW
Tp.				
H.	<u>2936</u>		<u>1096</u>	
Tr.	<u>2956</u>		<u>1116</u>	
Dg.				
Bl.				
L.	<u>2995</u>		<u>1155</u>	Geol.
K.C.				Contr.
B.K.C.				
Ce.				
C.				
M.				
M.				Pool
K.				Townsite
Mz.				<div style="text-align: center;"> <p><b>FIRST REPORT</b></p> <p><b>COMPLETE</b></p> </div>
Me.				
V.				
S.				
S.				
A	<u>3264</u>		<u>1424</u>	
R.				
PC.				
G.				
TD.	<u>3276</u>			

Date Comm. 5-5-55 JUN 15 1955

8" @ 889/100 5" @ 3265/75 CO to TD

B/  $\frac{1}{2}$  boph 4 hr. 500 A S/ 24 bo 3 hr.

Comp. 25 bopd

Co.  
Lse.  
No.  
Sec.  
T.  
R.