

Rice KANSAS


Section 2 Township 18 Range 8W

Well No. #2 Goodwin

Company Mallard Drlg.

Geneseo Pool

NORTH

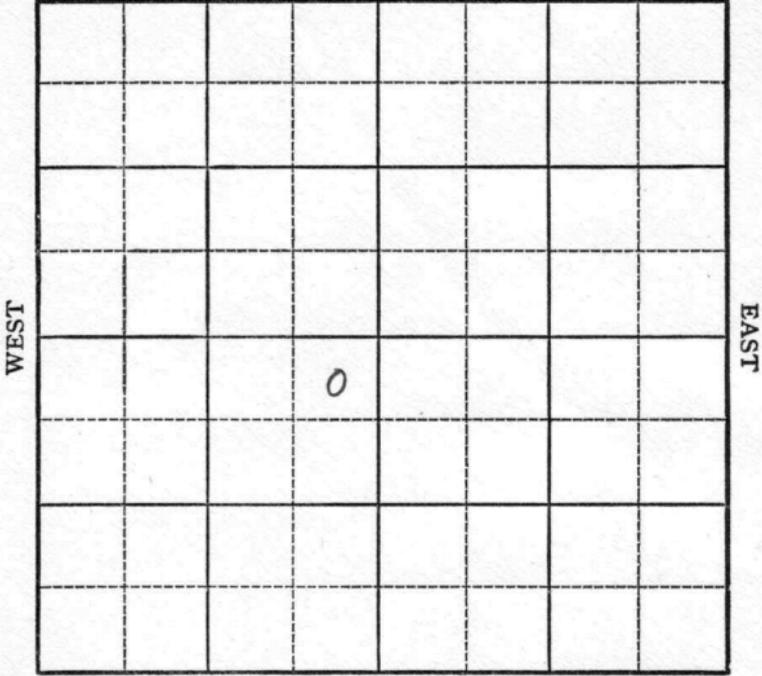

SOUTH

Rice
18

KANSAS

8W

Sec. 2 Twp. _____ R. _____

Well No. #2 Goodwin Farm _____

Mellard Drlg.

Geneseo Pool


(Mellard Drlg, ^{Company} Contr.)

330' Ft. from N. Line

_____ Ft. from S. Line

330' Ft. from E. Line

_____ Ft. from W. Line

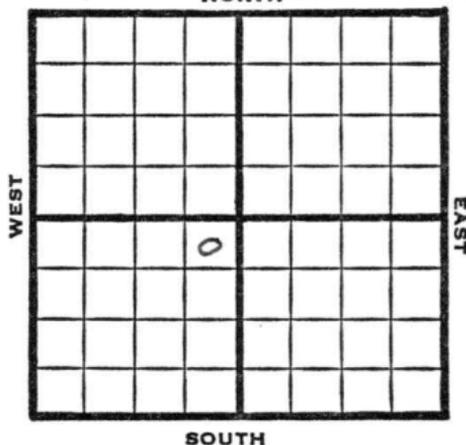

NE SW

1949 Elev 1774' REPORT

12/7 RUR
 12/14 8" @ 185'
 Lansing 2889'
 Drlg, 3196'
 12/21 Simpson 3281-94'
 TD 3294'
 5"@ 3289'
 12/28 Arb. 3316-17'
 TD 3317'
 36 shots 2866-2873
 1000 acid
 1950
 5/3 TD 3317'
 8"@ 185'
 Lans 2839'
 Simp 3281'
 Arb. 3316'
 5"@ 3289'
 Perf 36/2866-73
 P 3 BOPD
 60% Wtr.
 Comp

COMPLETED

Map No. _____ Sec. 2 Twp. 18 R. 8W

Well No. 2 Goodwin

Mallard Drlg. _____ Company

Mallard Drlg. _____ Contractor

FIRST REPORT
SECTION PLAT

NE SW

330 Ft. from N. Line

_____ Ft. from S. Line

330 Ft. from E. Line

_____ Ft. from W. Line

	o		

Rice County

Location _____

Rig up _____

Drilling and Remarks:

R U R

RECORD

Cased _____ in., _____ ft.

Sand _____

Gas _____

Oil _____

Total Depth _____

PRODUCTION

1st 24 hrs. Nat. _____

1st 24 hrs. after shot _____

Gas _____ Cu. Ft.

Dry Hole _____

Abandoned _____

Date

DEC 7 1949

19

S. J. LEWIS

Scout

Map No. _____ Sec. 2 Twp. 18 R. 8W

Well No. 2 Goodwin

Mallard Drlg. Company

Contractor

NE SW


El. 1774
SECTION PLAT

330 Ft. from N. Line

_____ Ft. from S. Line

330 Ft. from E. Line

_____ Ft. from W. Line

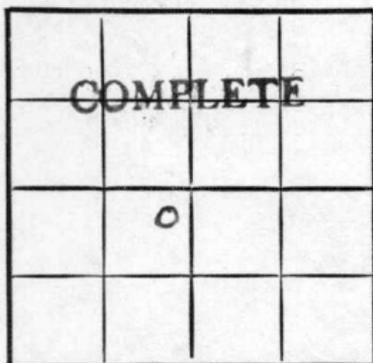

Rice County

Location _____

Rig up _____

Drilling and Remarks:

*8" @ 185
Lans 2839
Simp 3281
arb 3316
5" @ 3289*

per 136/2866-73

RECORD

Cased _____ in., _____ ft.

Sand _____

Gas _____

Oil _____

Total Depth 3317

PRODUCTION

1st 24 hrs. Nat. _____

1st 24 hrs. after shot _____

Gas _____ Cu. Ft.

Dry Hole _____

Abandoned _____

Date P 3 BOPD 60% water

MAY 3 1950₁₉

J. E. TYRA

Scout