


Section 19 Township 28 Range 6-E

Well No. #1 Sowers

Company Cromwell & Lewis

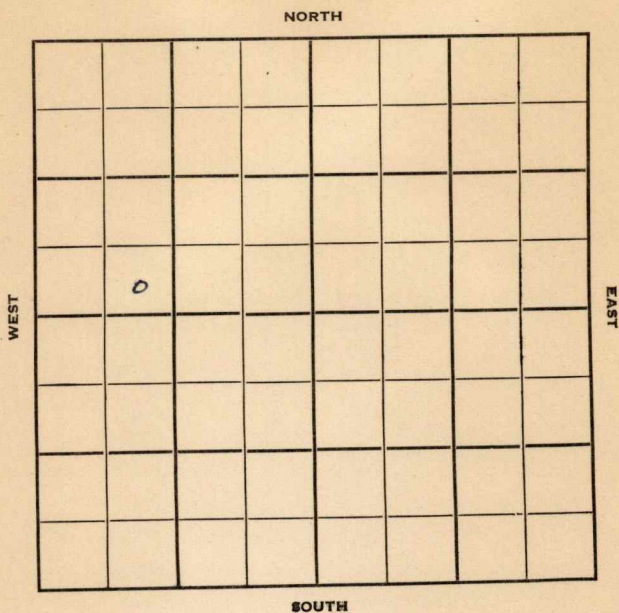

Sec. 19 Twp. 28 R. 6E

Well No. #1 Sowers Farm

Cromwell & Lewis Company

Contractor

Miscellaneous


Ft. from N. Line

330' Ft. from S. Line

Ft. from E. Line

990' Ft. from W. Line

SE SW NW

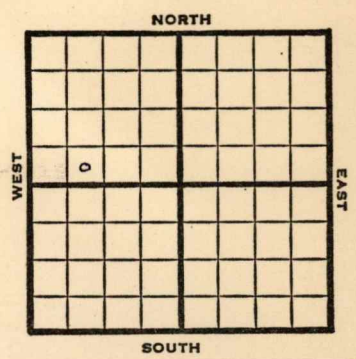

1950

**Elev 1386'**

REPORT

4/5

Drlg.

4/26

TD 2780'

8 5/8" @ 57'

**Bart 2622-23'**

5 1/2" @ 2622

**Miss 2780'**

TD 2780

D&A

Aband.

**ABANDONED**

Map No. \_\_\_\_\_ Sec. 19 Twp. 28 R. 6E

Well No. 1 Sowers

Cromwell & Lewis Company

Contractor

SE SW NW

SECTION PLAT

\_\_\_\_\_ Ft. from N. Line

330 Ft. from S. Line

\_\_\_\_\_ Ft. from E. Line

990 Ft. from W. Line

0			

FIKST REPORT

Butler County

Location \_\_\_\_\_

Rig up \_\_\_\_\_

Drilling and Remarks:

drlg.

RECORD

Cased \_\_\_\_\_ in., \_\_\_\_\_ ft.

Sand \_\_\_\_\_

Gas \_\_\_\_\_

Oil \_\_\_\_\_

Total Depth \_\_\_\_\_

PRODUCTION

1st 24 hrs. Nat. \_\_\_\_\_

1st 24 hrs. after shot \_\_\_\_\_

Gas \_\_\_\_\_ Cu. Ft.

Dry Hole \_\_\_\_\_

Abandoned \_\_\_\_\_

Date

APR 5 1950 19

J. E. TYRA

Scout

Map No. \_\_\_\_\_ Sec. 19 Twp. 28 R. 6E

Well No. 1 Sowers

Cromwell & Lewis Company

Contractor

SE SW NW

EI. 1386  
SECTION PLAT

\_\_\_\_\_ Ft. from N. Line

330 Ft. from S. Line

\_\_\_\_\_ Ft. from E. Line

990 Ft. from W. Line

ABANDONED			
o			

Butler County

Location \_\_\_\_\_

Rig up \_\_\_\_\_

Drilling and Remarks:

8 7/8" c 57  
 Bart. 2622-23  
 5 1/2" c 2622  
 Miss 2780  
 T.D. 2780  
 D+A

RECORD

Cased \_\_\_\_\_ in., \_\_\_\_\_ ft.

Sand \_\_\_\_\_

Gas \_\_\_\_\_

Oil \_\_\_\_\_

Total Depth 2780

PRODUCTION

1st 24 hrs. Nat. \_\_\_\_\_

1st 24 hrs. after shot \_\_\_\_\_

Gas \_\_\_\_\_ Cu. Ft.

Dry Hole \_\_\_\_\_

Abandoned \_\_\_\_\_

Date

APR 26 1950

19

J. E. TYRA

Scout