


Cowley KANSAS

DX 78-1

Section 20 Township 34 Range 3E
 Well No. 1 Booton "B"
 Company J. H. Wagner

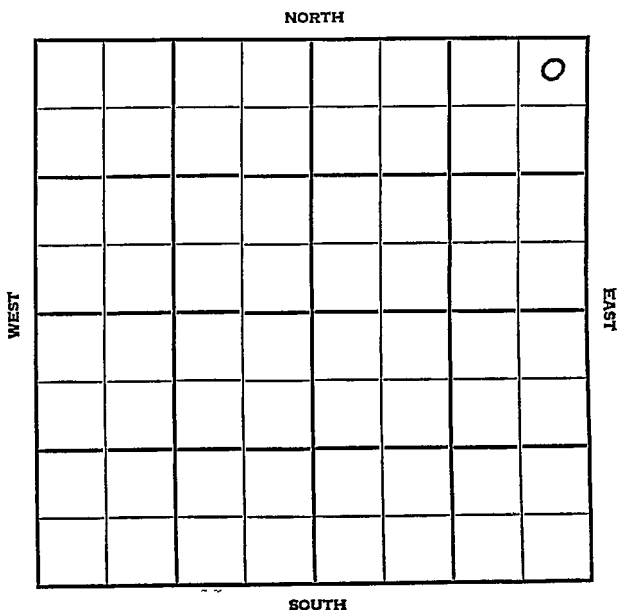

Cowley KANSAS

SEC.	TWP.	R.
20	34	3E

WELL NO.

1 Booton "B"

FARM

COMPANY

J. H. Wagner

CONTRACTOR

Smitherman

Baird Pool

330


Ft. from N. Line

Ft. from S. Line

330

Ft. from E. Line

Ft. from W. Line

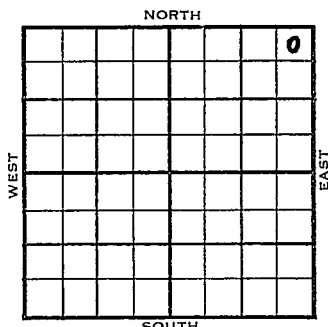

NE NE NE

	ELEVATION	REPORT
1954	1151'	

6/23

Spud 6-19-54

8" @ 93'

Drlg. 1575'

10/13

Spud 6-19-54 Oil well TD 3484

8" @ 93 Stal. 2232 Layton 2668

KC 2880' Cleve 3005 TD 3484

5" @ 3421 Bart. 3362 Miss 3392

Co to 3384 24/3371-76 23/3363-68


frac. S/586 BO 114 BW 24 hr.

Comp. 19 BOPD 40 BW

COMPLETED

J. G. McGEHEE

County Cowley State Kansas
 Sec. 20 (Blk. 34 (Sur. 3E Map No.
 (Twp.) (Rge.)
 Operator J. H. Wagner
 Well No. 1 Farm Booton "B"
 Elev. 1151 Location NE NE NE

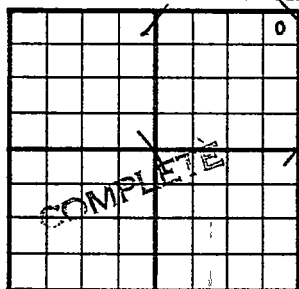

330 Ft. From N Line NE

330 Ft. From E Line Quarter

1st. Report

Completion OCT 13 1954

Remarks Baird Pool

Smitherman - Contr.

Spudding Date 6-19-54

Drig. Data Oil well TD 3484

8" @ 93 Stal. 2232 Layton 2668

KC 2880 Cleve. 3005 TD 3484 5" @ 3421

Bart. 3362 Miss. 3392 CO to 3384

24/ 3371-76 23/ 3363-68 frac

S/ 586 bo 114 bw 24 hr.

Comp. 19 bopd 40 bw

FABEN GILSON