


Butler

Map No. Kansas Sec. 20 Twp. 28 R. 6

Well No. 3 Pettit Farm

~~Cornell Oil~~ Company
MAGNOLIA

990 Ft. from N. Line
 _____ Ft. from S. Line
330 Ft. from E. Line
 _____ Ft. from W. Line

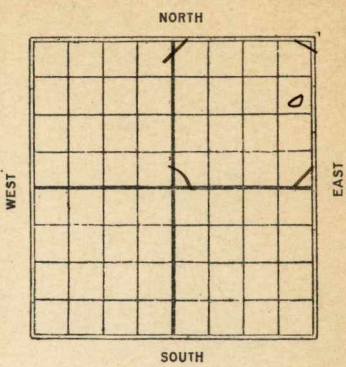

Date	REPORT	
7/26		
4/7	Location	
4/7	_____	
4/14	_____	
4/21	_____	
4/30	Bldg Rig	
5/8	Rig	
5/12	Spudding	
5/19	Drlg. 700'	
6/2	" 1750'	
6/10	show gas 2115-20 drlg - 2230	
6/18	Dlg. 2465'	
6/25	" 2900	
6-30	" 3185	
7/8	" 3205' H.F.W	
7/15	" 3350 H.F.W.	
7/22	" 3400	
7/28	" 3495	
8/4	_____	
8/18	D & A 3550 - T.D.	

Butler

K11 KANSAS Sec. *20* Twp. *28* R. *6*

Well No. *2 Pettit*

Cornell oil Co

Company

Contractor

FIRST REPORTS

SECTION PLAT

990 Ft. from N. Line

Ft. from S. Line

330 Ft. from E. Line

Ft. from W. Line

Location

Rig up

Drilling and Remarks:

RECORD

Cased _____ in., _____ ft.

Sand _____

Gas _____

Oil _____

Total Depth _____

PRODUCTION

1st 24 hrs. Nat. _____

1st 24 hrs. after shot _____

Gas _____ Cu. Ft.

Dry Hole _____

Abandoned _____

Date

APR 7 1926

CHAS. L. SHERWOOD

192

Scout

Butler


Map No. *K11* KANSAS Sec. *20* Twp. *28* R. *6*

Well No. *3* *Butler*

Magnolia Let Co Company

Contractor

SECTION PLAT

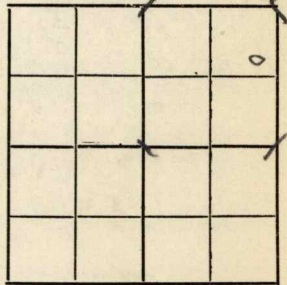

990 Ft. from N. Line

Ft. from S. Line

330 Ft. from E. Line

Ft. from W. Line

CORRECTION

Location

Rig up

Drilling and Remarks:

809 leg
Revisedly reported
to #2. ch well
to and ownership
to above

RECORD

Cased _____ in., _____ ft.

Sand _____

Gas _____

Oil _____

Total Depth _____

PRODUCTION

1st 24 hrs. Nat. _____

1st 24 hrs. after shot _____

Gas _____ Cu. Ft.

Dry Hole _____

Abandoned _____

Date

APR 28 1926

CHAS. L. SHERWOOD

192

Scout

Butler

11 KANSAS 20 Sec. Twp. 28 R. 6
Map No.-----

Well No. 3 Lett

magnolia Let Co

Company

Contractor

COMPLETED

SECTION PLAT

990 Ft. from N. Line

			0

----- Ft. from S. Line

330 Ft. from E. Line

----- Ft. from W. Line

ABANDONED

Location -----

Rig up -----

Drilling and Remarks:

10K

3550'

RECORD

Cased ----- in., ----- ft.

Sand -----

Gas -----

Oil -----

Total Depth 3550

PRODUCTION

1st 24 hrs. Nat. -----

1st 24 hrs. after shot -----

Gas ----- Cu. Ft.

Dry Hole

Abandoned

Date

AUG 18 1926

CHAS. L. SHERWOOD

192

Scout