


Map No. _____ Sec. 20 Twp. 34 R. 3
Well No. 1 Shurtz Farm _____
Elwell Oil Company _____

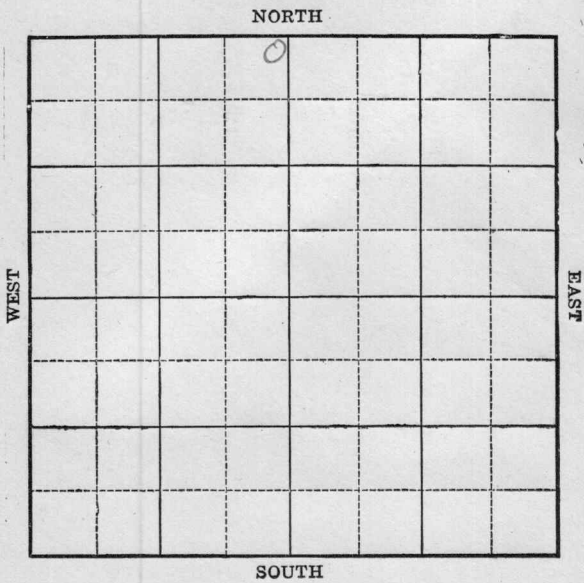

Location _____

Rig up _____

Drilling Remarks:

Drilling Remarks:

RECORD

PRODUCTION

Cased _____ in. _____ ft.

Sand _____

Gas _____

Oil _____

Total Depth _____

1st 24 hrs Nat. _____

1st 24 hrs. after shot _____

Gas _____ cu. ft.

Dry Hole _____

Abandoned _____

Kansas

Map No. **KANSAS** Sec. *20* Twp. *34* R. *3*

Well No. *1-shurtz*

E. Swell et al Company

Contractor

FIRST REPORT

SECTION PLAT

200 Ft. from N. Line

_____ Ft. from S. Line

200 Ft. from E. Line

_____ Ft. from W. Line

	0		

Location *✓ ✓*

Rig up _____

Drilling and Remarks:

RECORD

Cased _____ in., _____ ft.

Sand _____

Gas _____

Oil _____

Total Depth _____

PRODUCTION

1st 24 hrs. Nat. _____

1st 24 hrs. after shot _____

Gas _____ Cu. Ft.

Dry Hole _____

Abandoned _____

Date **JAN 12 1923**

191 *M. A. BENEAR* Scout

Pub. No. 1707-21

60/

shopless stark
6-21-13. will dly well
P.O. Is will dly - 10-22-15

Moody plan book
Frank's plan book
Moody map
Frank's map
J. S. C. map
Tracing
Cards
Returned

SECTION 1771

Map No. **KANSAS** Sec. *20* Twp. *34* R. *3*

Well No. *1 Shurtz*

Shawver & Butler Company

Contractor

ABANDONED SECTION PLAT

200 Ft. from N. Line

_____ Ft. from S. Line

200 Ft. from E. Line

_____ Ft. from W. Line

	<i>0</i>		

Location _____

Rig up _____

Drilling and Remarks:

2049
3418'

RECORD

Cased _____ in., _____ ft.

Sand _____

Gas _____

Oil _____

Total Depth _____

PRODUCTION

1st 24 hrs. Nat. _____

1st 24 hrs. after shot _____

Gas _____ Cu. Ft.

Dry Hole _____

Abandoned _____

Date

AUG 15 1923

M. A. BENEAR

192

Scout

Cowley

K1
MAP NO. KANSAS SEC. 20 TWP. 34S R. 3E

WELL NO. 1 Huntz
Shawnee & Sutter COMPANY

CONTRACTOR

ABANDONED

SECTION PLAT

_____ FT. FROM N. LINE
 _____ FT. FROM S. LINE
 _____ FT. FROM E. LINE
 _____ FT. FROM W. LINE

LOCATION _____

RIG UP _____

DRILLING AND REMARKS:

JK

RECORD

CASED _____ IN. _____ FT.
 SAND _____
 GAS _____
 OIL _____
 TOTAL DEPTH 3418

PRODUCTION

1ST 24 HRS. NAT. _____
 1ST 24 HRS. AFTER SHOT _____
 GAS _____ CU. FT.
 DRY HOLE
 ABANDONED

DATE

8/8