


Section 20 Township 34 Range 3E

Well No. #2 Shurtz

Company Goldenstern & Stolper

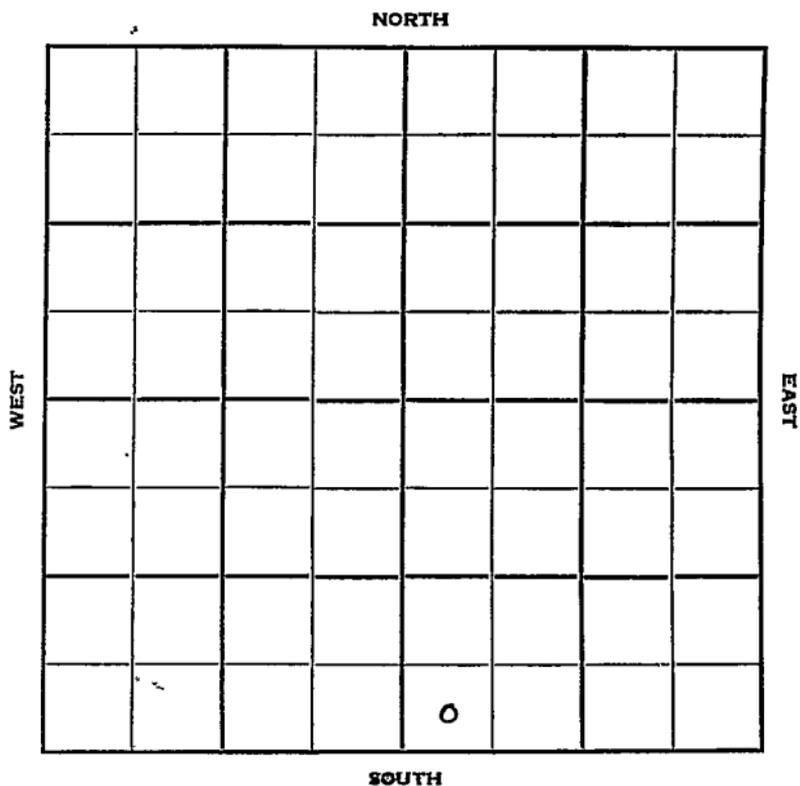

Cowley

KANSAS  
R. 3E

Sec. 20 Twp. 34

Well No. #2 Shurtz Farm

Goldenstern & Stolper Company

Contractor


Gibson Pool

Ft. from N. Line

330' Ft. from S. Line

Ft. from E. Line

330' Ft. from W. Line

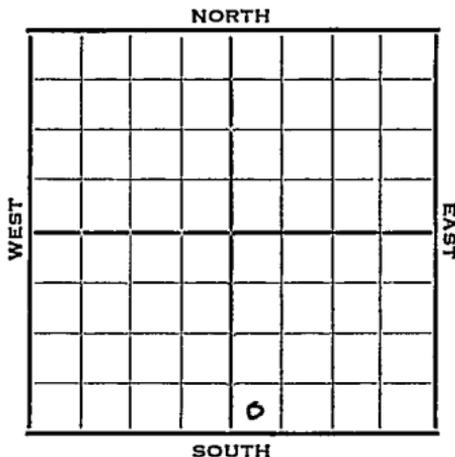

SW SW SE

1952

Elev. 1133' REPORT

3/19

Spud 2-9-52  
 Oil Well TD 3371  
 8" @ 123  
 Simp 3343 TD 3344  
 5" @ 3343 DD 3371  
 B/2 bopd Hydra  
 Comp. 30 bopd

FIRST REPORT  
 COMPLETED



Cowley

Map No. \_\_\_\_\_ Sec. 20 Twp. 34 R. 3E

Well No. 2 Shurts.

Soldenstern & Stolper Company

Contractor

sw sw se


\_\_\_\_\_ Ft. from N. Line

330 Ft. from S. Line

\_\_\_\_\_ Ft. from E. Line

330 Ft. from W. Line

SECTION PLAT

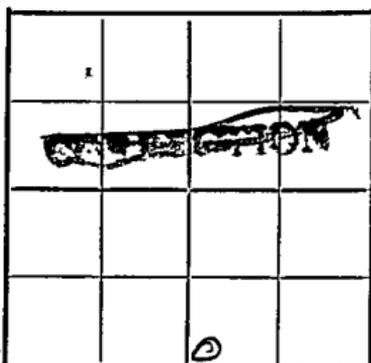

**FIRST**  
~~Report~~

Location \_\_\_\_\_

Rig up \_\_\_\_\_

Drilling and Remarks:

Reported

~~sw sw se~~

RECORD

Cased \_\_\_\_\_ in., \_\_\_\_\_ ft.

Sand \_\_\_\_\_

Gas \_\_\_\_\_

Oil \_\_\_\_\_

Total Depth \_\_\_\_\_

PRODUCTION

1st 24 hrs. Nat. \_\_\_\_\_

1st 24 hrs. after shot \_\_\_\_\_

Gas \_\_\_\_\_ Cu. Ft.

Dry Hole \_\_\_\_\_

Abandoned \_\_\_\_\_

Date

3-9-52 19

JG 4/1 Scout