


Map No. Kansas Sec. 20 Twp. 28 R. 6

Well No. 1 Pettit Farm _____
Cornell oil Company _____

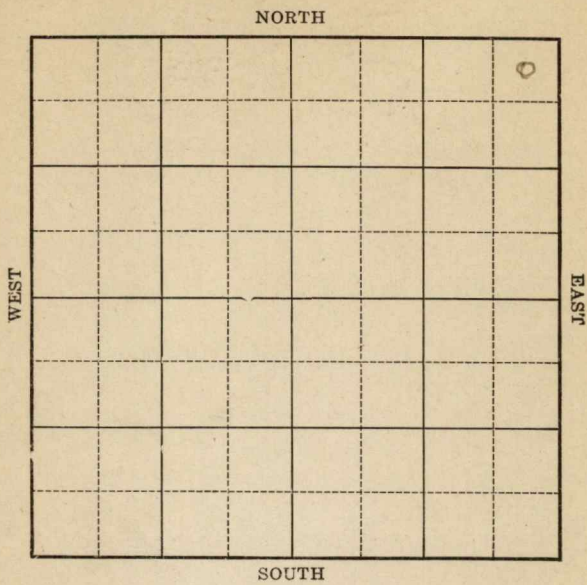

Location _____

Drilling Remarks _____

Rig Up _____

Drilling Remarks _____

RECORD

Cased _____ in. _____ ft.

Sand _____

Gas _____

Oil _____

Total Depth _____

PRODUCTION

1st 24 hrs. Nat. _____

1st 24 hrs. after shot _____

Gas _____ cu. ft.

Dry Hole _____


Abandoned _____

Butler Co

Map No. Kansas Sec. 20 Twp. 28 R 6

Well No. 1 Pettit Farm
Connell oil Company

250 Ft. from N. Line
 _____ Ft. from S. Line
250 Ft. from E. Line
 _____ Ft. from W. Line

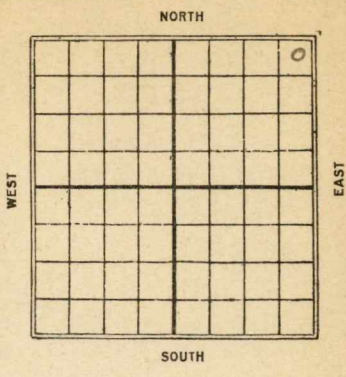

Date	REPORT
1/20	Dlg 450
1/27	✓ 1100.
2/4	Dlg 1265'
2/10	✓ 1765'
2/17	✓ 1810
2/24	✓ 2340
3/5	Dlg 2755
3/10	" 2827
3/18	" 3010
3/24	Top Wilcox 3140-45 filled up. 2500 feet water, the oil seemed to come thro water, water exhausted (Zel)
3/26	Top sand 3138-44 T.D. 3144 Correct T.D. 2800 ft oil in hole ran swab & swabbed down to 1500 ft & it filled up fast set 5" 3087 (Zel)
3/25-	Top Wilcox 3138-44 Cable measure filled up 2800 oil pulling big pipe

4/1 - Top Wilcox (S2m) - 3138-
3143 - Pumped 135 BBls
1st - 12 hrs.

4/7 - Pumped 135 BBls.
first 12 hours, 75 BBls.
second 12 hours, 156
BBls next 20 hours.
170 - Second 20 hours.
Through 2" tubing
Running 3" tubing.

4/14 - Sand 3138-3143 Pumping
240 bbls

Map No. **K11** **KANSAS** Sec. **20** Twp. **28** R. **6**

Well No. **1** **Connell Oil Co.** Company

Contractor

FIRST REPORTS

SECTION PLAT

250 Ft. from N. Line

_____ Ft. from S. Line

250 Ft. from E. Line

_____ Ft. from W. Line

			o

Location _____

Rig up _____

Drilling and Remarks:

July 450'

RECORD

Cased _____ in., _____ ft.

Sand _____

Gas _____

Oil _____

Total Depth _____

PRODUCTION

1st 24 hrs. Nat. _____

1st 24 hrs. after shot _____

Gas _____ Cu. Ft.

Dry Hole _____

Abandoned _____

Date

JAN 20 1926
192

CHAS. L. SHERWOOD
Scout

Butler

Map No. *K11* KANSAS *20* Sec. *28* Twp. *28* R. *6*

Well No. *1 Little*

Connell Oil Co Company

Contractor

COMPLETED

SECTION PLAT

250 Ft. from N. Line

Ft. from S. Line

250 Ft. from E. Line

Ft. from W. Line

			<i>0</i>

Location *Wilcox*

Rig up

Drilling and Remarks:

Dep Run 2805

dumpling 240 ft natural

RECORD

Cased *3138-3143* in., *3143* ft.

Sand

Gas

Oil

Total Depth *3143*

PRODUCTION

1st 24 hrs. Nat. _____

1st 24 hrs. after shot. _____

Gas _____ Cu. Ft.

Dry Hole _____

Abandoned _____

Date

APR 14 1926

CHAS. L. SHERWOOD

Scout