


Section 2 Township 18 Range 8W

Well No. #1 Gregory

Company Francis Raymond

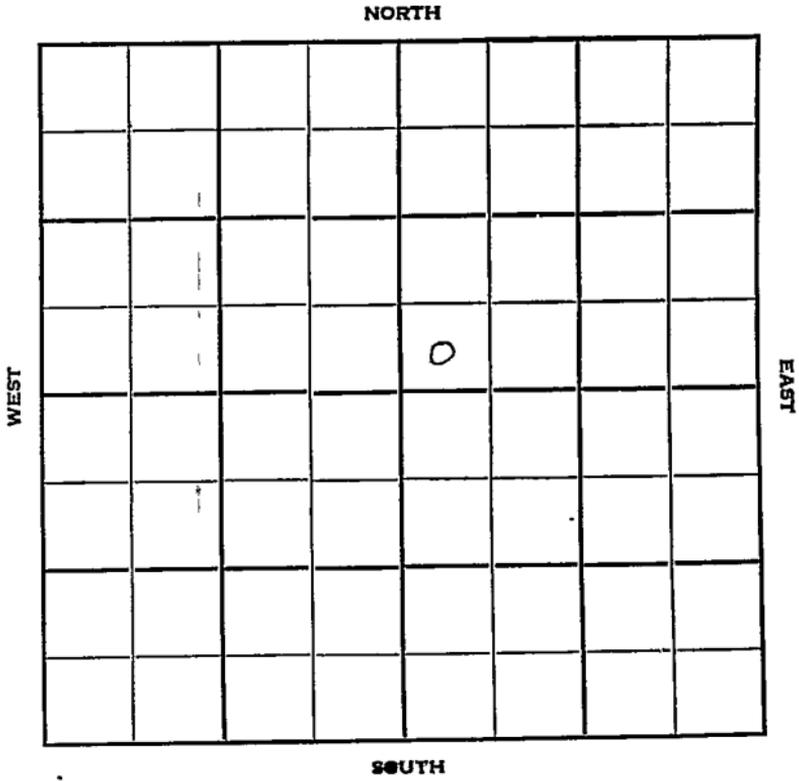


Sec. 2 Twp. 18 R. 8-W

Well No. #1 Gregory Farm

Francis Raymond Company

Contractor

 Ft. from N. Line
330 Ft. from S. Line
 Ft. from E. Line
330 Ft. from W. Line

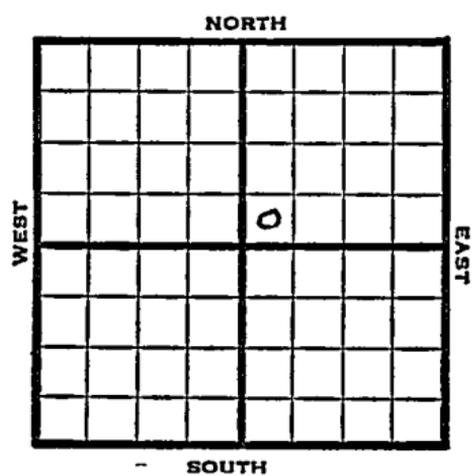

SW SW NE

1950

Elev. 1765' REPORT

12/13

Location

1951
1/10

Spud 12-27-50
 D&A TD 3295
 8" @ 189' Heeb. 2682 Br Lime 2805
 Lans. 2832 Cong. 3205
 DST 3201-27 opn 1 hr Rec. 30'
 mud Simp. 3262
 DST 3248-65 opn 1 hr Rec. 280' wtr
 DST 3279-95 opn 1 hr Rec. 30' wtr
 TD 3295 D&A

ABANDONED

County Rice State Kansas

Sec. 2 (Blk. 18) (Sur. 8W) (Twp.) (Rge.) Map No.

Operator Francis Raymond

Well No. 1 Farm Gregory

Elev. 1765 Location SW SW NE

ABANDONED

330 Ft. From S Line NE

330 Ft. From W Line Quarter

Ist. Report

Completion JAN 1 0 1951

Remarks

Spudding Date 12-27-50

Drlg. Data D & A TD 3295

8" @ 189 Heeb. 2682 Br. lime 2805

Lans. 2832 Cong. 3205 DST 3201-27

open 1 hr. Rec. 30' mud Simp. 3262

DST 3248-65 open 1 hr. Rec. 280' water

DST 3279-95 open 1 hr. Rec. 30' water

TD 3295 D & A

J. E. TYRA