
DX 78-1 Rice KANSAS

Section 2 Township 18S Range 8W

Well No. #1 Keller

Company K & E Drlg

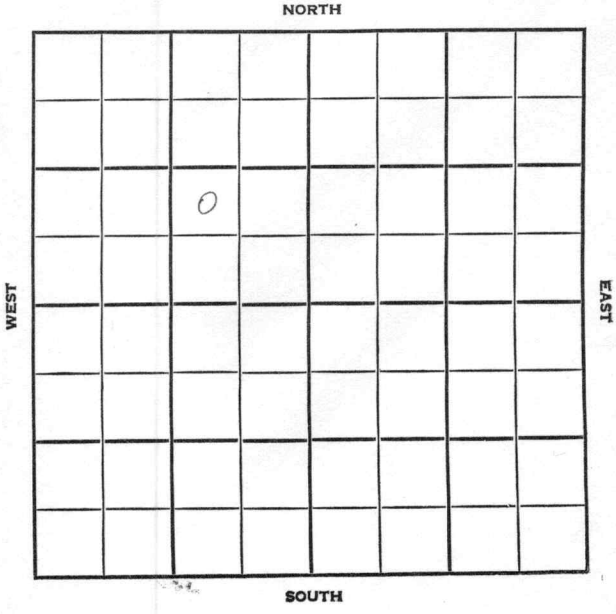

Rice KANSAS

SEC.	TWP.	R.
2	18	8W

WELL NO.

#1 Keller FARM

COMPANY

K & E Drlg.

CONTRACTOR

Co. Tools


_____ FT. FROM N. LINE

_____ FT. FROM S. LINE

_____ FT. FROM E. LINE

_____ FT. FROM W. LINE

NW SE NW

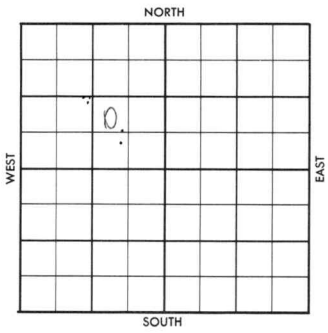

1956	ELEVATION 1775 RB	REPORT

8-15 Comm. 8-8-56
8" @ 240 w/150
DST 2863-98 op ½ hr., weak blo, 12 min. rec. 15' mud, 0#;
Drlg. 2950'
H.. 2700'; Tr. 2722'; Dg. 2738';
BL. 2821'; L. 2849';

8-22 DST 3232-50 op 30 min. rec. 10' mud, BHP 270#.
DST 3304-30 op 1 hr., rec. 1230' SW, FP 130-560#, BHP 860/20".
D & A
C. 3230'; A. 3351';
TD 3362'

ABANDONED

FORM 504-5 SUNRAY

FORM 513 SUNRAY

County Rice Elev. 1775 RB

Sec. 2 Twp. 18S Rge. 8W

Company K & E Drlg.

Farm Name Keller No. 1

TOPS	DEPTH	LOG	DATUM
Anh.			
Tp.			
H.	2700		
Tr.	2732		
Dg.	2758		
B.L.	2821		
L.	2874		
K.C.			
B.K.C.			
Ce.			
C.			
M.			
M.			
K.			
Mz.			
Mq.			
V.			
S.			
S.			
A			
R.			
P€.			
G.			
T.D.			

Loc. in Sec. NW SE NW

DS - S½ NW¼

Geol.

Contr. Co. rig #1

Pool



Date Comm. 8-8-56

8" 240 w/150; DST 2863-98 op 1/2 hr. weak blo 12", rec. 15' mud, 0#; D 2950

Co. Lse. No. Sec. T. R.

FORM 513 SUNRAY

County Rice Elev. 1775 RB

Sec. 2 Twp. 18S Rge. 8W

Company B & B Drlg.

Farm Name Keller No. 1

TOPS	DEPTH	LOG	DATUM
Anh.			
Tp.			
H.	2709		
Tr.	2722		
Dg.	2738		
Bl.	2821		
L.	2879		
K.C.			
B.K.C.			
Ce.			
C.	3230		
M.			
M.			
K.			
Mz.			
Mg.			
V.			
S.			
S.			
A	3351		
R.			
P€.			
G.			
T.D.	3362		


Loc. in Sec. NW SE NW

DS - S½ NW¼

Geol.

Contr. Co. rig #1

Pool

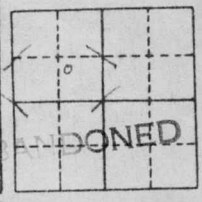

Date Comm. 8-8-56 AUG 22 1956

8" 240 w/150; DST 2862-98 op 1/2 hr. weak blo 12", rec. 15' mud, O/; D 2950

AUG 22 56 DST 3232-50 30" rec 10' Md BHP 270 DST 3304-30 1hr 1230' SW FP 130-560 BHP 860/20"

DEQ