

Butler

FORM 51

KANSAS

Section 16 Township 28 Range 4E

Well No. #3 Cunningham

Company Morris Sitrin

NORTH

WEST

EAST

						0	

SOUTH

SEC.	TWP.	R.
16	28	4E ✓

WELL NO.

3 Cunningham

FARM

COMPANY

Morris Sitrin

CONTRACTOR


Augusta Pool

330 Ft. from N. Line

Ft. from S. Line

990 Ft. from E. Line

Ft. from W. Line

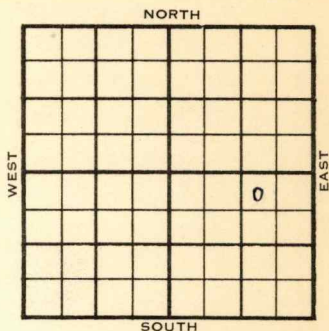

NW NE SE

1953

ELEVATION

1206'

REPORT

12/9

Cellar & Pits

12/30

Spud 12-9-53

Oil Well

TD 2560'

Simp. 2464', Arb. 2471'

TD 2560'

5" @ 2560

CO to TD

6/2526-30, 12/2530-38

Comp. 30 bopd 30 bw

COMPLETED

County **Butler** State **Kansas**
 Sec. **16** (Blk. **28** (Sur. **4E** Map No.
 (Twp.) (Rge.)
 Operator **Morris Sitrin**
 Well No. **3** Farm **Cunningham**
 Elev. Location **NW NE SE**



330 Ft. From **N** Line **SE**
990 Ft. From **E** Line Quarter
 1st. Report **DEC 9 1953**

Completion

Remarks

Spudding Date

Drlg. Data

Augusta Pool

Cellar & pits

J. G. McGEHEE

County Butler State Kansas

Sec. 16 (Blk. Twp.) 28 (Sur. Rge.) 4E Map No.

Operator Morris Sitrin

Well No. 3 Farm Cunningham

Elev.	1206	Location	NW NE SE
-------	------	----------	----------

COMPLETE

0

330 Ft. From N Line SE

990 Ft. From E Line Quarter

1st. Report

Completion

Remarks Augusta Pool

Spudding Date 12-9-53

Drig. Data Oil well TD 2560

Simp. 2464 Arb. 2471 TD 2560

5" @ 2560 CO to TD 6/ 2526-30

12/ 2530-38 Comp. 30 bopd 30 bw

J. G. McGEHEE