O.W.W.O. KANSAS Rice


FORM 51 10M 12-46 PETROL

Section 3 Township 18 Range 8W

Well No. 2 Dubrinski

Company ~~Phil Han~~ FRANCIS RAYMOND

Geneseo

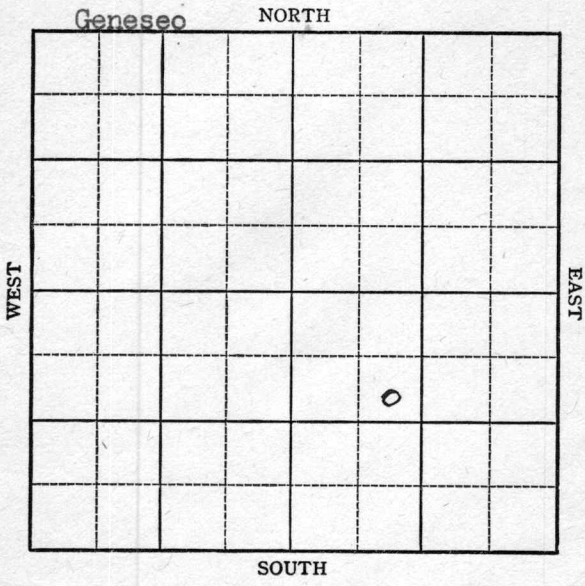

FORM 252-A
5M 6-46 PETROL

O.W.W.O. KANSAS Rice

Sec. 3 Twp. 18 R. 8-W

Well No. #2 Dubrinski Farm

FRANCIS RAYMOND
~~Phil-Han~~ Company

Murfin Drlg. - Contr.


990 Ft. from N. Line

Ft. from S. Line

Ft. from E. Line

990 Ft. from W. Line

SE NW SE

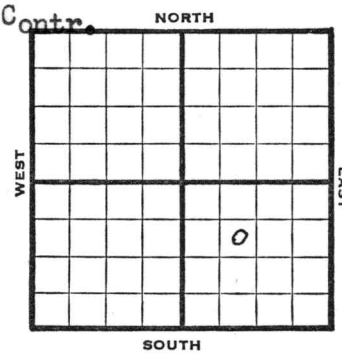

1947	REPORT
	Elev. 1786
4/9	Location
4/15	10" @ 275' Drlg. 2565'
4/23	Arb 3286 TD 3300'
	ABANDONED
1954	O.W.W.O.
1/13	OWWO for SWD Arb. 3286' OTD 3300' To DD for SWD
1/27	Will Not be SWD DST 3292-3304 RTD 1 hr., 180' gas, 780' hly ocm, 1320' gassy oil, 360' wtr, 1045# 5" @ 3292', CO 3304, FU 2700' oil
2/3	50 M-A P/76 bopd
2/10	Oil well TD 3304 Arb. 3286 OTD 3300 DST 3292-3304 open 1 hr, rec 180' gas, 780' HOCM, 1320' gassy oil 360' wtr. 1045# 5" @ 3292 CO to 3304' FU 2700' oil 50 mud-acid. P/76 BOPD Comp. 153 BOPD
	COMPLETED

Form 26 200 Bks. 10-46 Petrol KANSAS Geneseo Pool
Kansas

Map No. K45 Sec. 3 Twp. 18 R. 8W

Well No. 2 Dabrinski

Phil-Han Company

FIRST REPORT Contractor

SE NW SE


990 Ft. from N. Line

____ Ft. from S. Line

____ Ft. from E. Line

990 Ft. from W. Line

SECTION PLAT

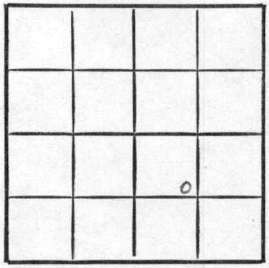

Rice County

Location x

Rig up

Drilling and Remarks:

RECORD

Cased ____ in., ____ ft.

Sand

Gas

Oil

Total Depth

PRODUCTION

1st 24 hrs. Nat.

1st 24 hrs. after shot

Gas ____ Cu. Ft.

Dry Hole

Abandoned

Date

APR 9 1947 19 S. J. LEWIS Scout

Form 26 200 Bks. 10-46 Petrol

Kansas KANSAS

Geneseo Pool

Map No. 45 Sec. 3 Twp. 18 R. 8W

Well No. 2 Dabrinski


Phil-Han Company

ABANDONED Contractor

SE NW SE

E 1/2 SE

SECTION PLAT

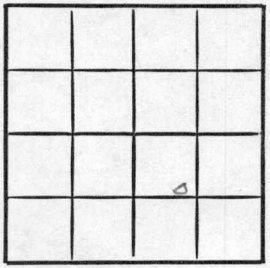

990 Ft. from N. Line

Ft. from S. Line

Ft. from E. Line

990 Ft. from W. Line

Rice County

Location

Rig up

Drilling and Remarks:

Cert 8286

RECORD

Cased in., ft.

Sand

Gas

Oil

Total Depth 3300

PRODUCTION

1st 24 hrs. Nat.

1st 24 hrs. after shot

Gas Cu. Ft.

Dry Hole

Abandoned

Date

APR 23 1947 19 S. J. LEWIS Scout

FORM 275 FOR SALE BY KANSAS BLUE PRINT CO.

O.W.W.O.

County Rice State Kansas

Sec. 3 (Blk. Twp.) 18 (Sur. Rge.) 8W Map No.

Operator Francis Raymond (was Phil-Han)

Well No. 2 Farm Dubrinski

Elev. 1786 Location SE NW SE



990 Ft. From N Line SE

990 Ft. From W Line Quarter

1st. Report JAN 13 1954

Completion O.W.W.O.

Remarks OWWO for SWD

Murfin Drlg. - Contr.

Spudding Date

Drlg. Data

Arb. 3286 OTD 3300 to DD for SWD

J. G. McGEHEE

FORM 275 FOR SALE BY KANSAS BLUE PRINT CO.

O.W.W.O.


County Rice State Kansas

Sec. 3 (Blk. Twp.) 18 (Sur. Rge.) 8W Map No.

Operator Francis Raymond (was Phil-Han)

Well No. 2 Farm Dubrinski

Elev. 1786 Location SE NW SE

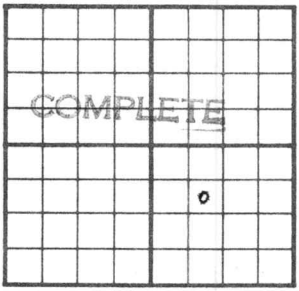

990 Ft. From N Line SE

990 Ft. From W Line Quarter

1st. Report

Completion FEB 10 1954

Remarks OWWO O.W.W.O.

Muffin Drlg. - Contr.

Spudding Date

Drlg. Data Oil well TD 3304

Arb. 3286 OTD 3300 DST 3292-3304

open 1 hr. Rec. 180' gas 780' hocm

1320' gassy oil 360' wtr. 1045#

5" @ 3292 CO to 3304 FU 2700' oil

50 mud-acid P/ 76 bopd

Comp. 153 bopd

J. G. McGEHEE