


Section 3 Township 18 Range 8W

Well No. #5 Dobrinski

Company Francis Raymond

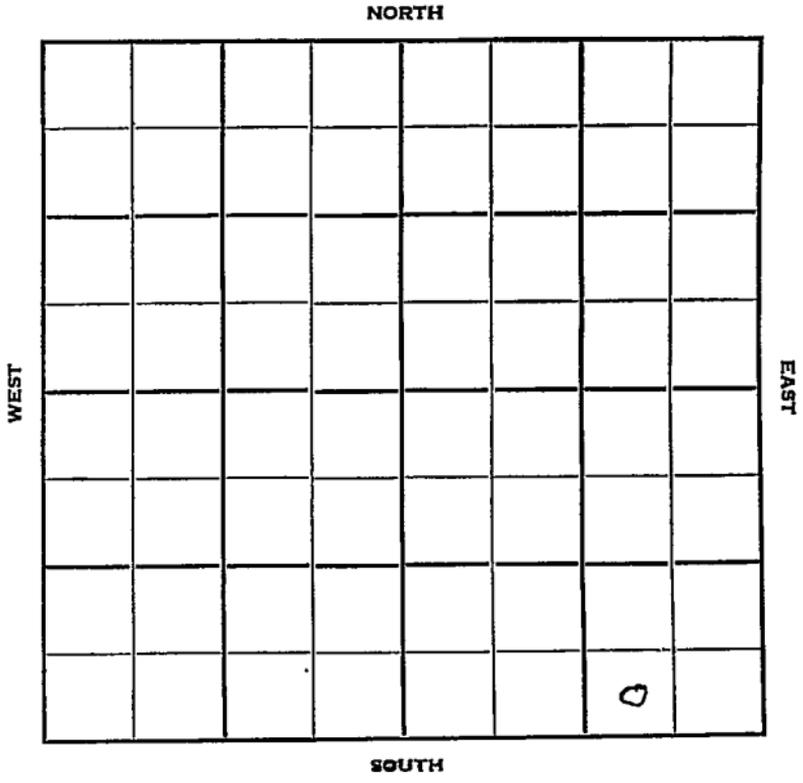

Sec. 3 Twp. 18 R. 8W

Well No. #5 Dobrinski Farm

Francis Raymond Company

Murfin - Contr. Contractor


..... Ft. from N. Line

330' Ft. from S. Line

990' Ft. from E. Line

..... Ft. from W. Line

SW SE SE

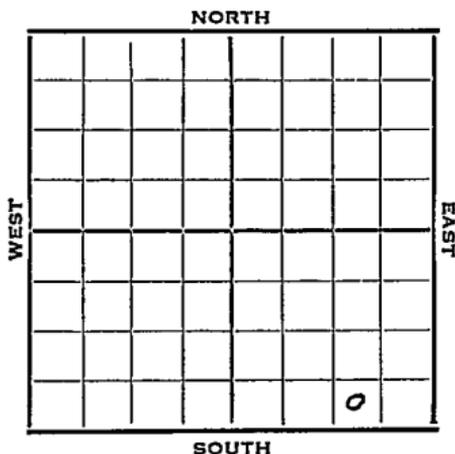

1952 Elev. 1784' REPORT

- 5/7 RUR
- 5/14 8" @ 233 Anhy 590
Drlg. 2818'
- 5/21 Heeb 2715' Br li 2844' Lans. 2865'
Cong. 3199' Arb. 3296'
TD 3307' 5" @ ?
- 5/28 DST 3297-3307' 1/2 hr. 680' gas 35' oil
165' MCO 900# 7" @ 3299' CO 3307
fill up 400' oil 24 hrs. POP
- 6/11 Spud 5-6-52
Oil Well TD 3307
8" @ 233 Anhy 590
Heeb. 2715 Br lime 2844
Lans. 2865 Cong. 3199
Arb. 3296 TD 3307 7" @ 3299
DST 3297-3307 opn 1/2 hr. Rec. 680'
gas 35' oil 165' mco TD 3307
FU 400' oil overnite
Comp. 329 bopd

COMPLETED

